

**SURVEYOR'S NARRATIVE:**

THE PURPOSE OF THIS SURVEY IS TO STAKE THE EAST RIGHT OF WAY LINE OF GLEMM ROAD SO THE SETBACK CAN BE DETERMINED FOR A BUILDING ADDITION. ALSO TO STAKE THE EAST LINE OF THE WEST HALF OF THE WEST HALF OF THE SW 1/4 OF SECTION 24 SO A NEW FENCE CAN BE BUILT.

I SURVEYED THE WEST LINE OF SAID SW 1/4 IN A 2001 SURVEY FOR BURMESTER-ERHARDT AND THIS SURVEY AND THE BEARINGS ARE BASED ON THAT SURVEY.

I COMPUTED THE CENTER 1/4 CORNER FROM MY 1987 COUNTY REMONUMENTATION SURVEY.


THIS PROPERTY IS DESCRIBED IN A DEED TO PERRY AND SARA BURROUGHS ON INSTRUMENT # 2012-5980124 AND IS DESCRIBED AS THE WEST HALF OF THE WEST HALF OF THE SW 1/4 OF SECTION 24, T 4 N, R 28 E, WILLAMETTE MERIDIAN, UMATILLA COUNTY, OREGON, EXCEPTING THEREFROM ANY COUNTY ROAD RIGHTS OF WAY.

I USED A TOPCON HIPER+ G.P.S. IN REAL TIME TO CONDUCT THIS SURVEY.

REGISTERED  
PROFESSIONAL  
LAND SURVEYOR

*G. Dennis Edwards*

OREGON  
JULY 16, 1971  
G. DENNIS EDWARDS  
9 5 1  
RENEWS 12/31/2013

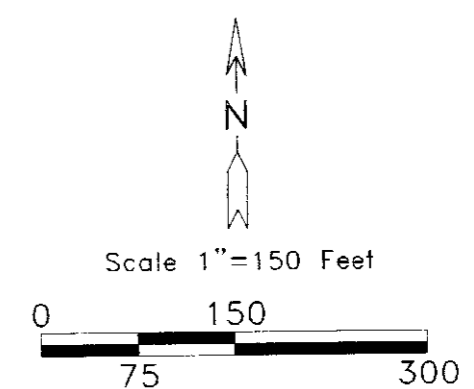

**LEGEND:**

- FOUND 2 1/2" B.C. SET BY ME IN AREA ONE 1987 COUNTY SURVEY, UNLESS NOTED OTHERWISE
- SET 5/8"X30" IRON REBAR WITH PLASTIC CAP #951, UNLESS NOTED AS 12"
- ⊙ SET WOOD STAKE
- ⊙ COMPUTED LOCATION
- (000) OF RECORD, MY 2001 SURVEY FOR BURMESTER-ERHARDT

**RECEIVED BY**  
Umatilla County Surveyor  
Date: 4/30/2013  
Rec'd By: S. Oliver  
No.: 13-142-B

SURVEY FOR PERRY BURROUGHS  
IN SW 1/4, SEC. 24, T 5 N, R 28 E, W.M.,  
UMATILLA COUNTY, OREGON  
04/08/2013 JOB# S1304027  
EDWARDS SURVEYING P.O. BOX 763  
541-567-3336 HERMISTON, OREGON 97838  
DRAWN BY JMC