

N.W. Cor of  
SW 1/4, SW 1/4, Sec 2  
T 2N, R 32E, W.M.


Horn & N 88° 00' 20" E (Cor.)  
 Gilliam & 88 00 40 (Cor.)  
 Furnish & 88 01 00 (Cor.)  
 Ellis & N 88° 01' 20" E (Cor.)  
 Despain & N 88° 01' 40" E (Cor.)

N. Main &  
 N 01° 59' 30" W (Cor.)  
 from control map



SCALE: 1" = 50'

12-10-70  
 11-11-71

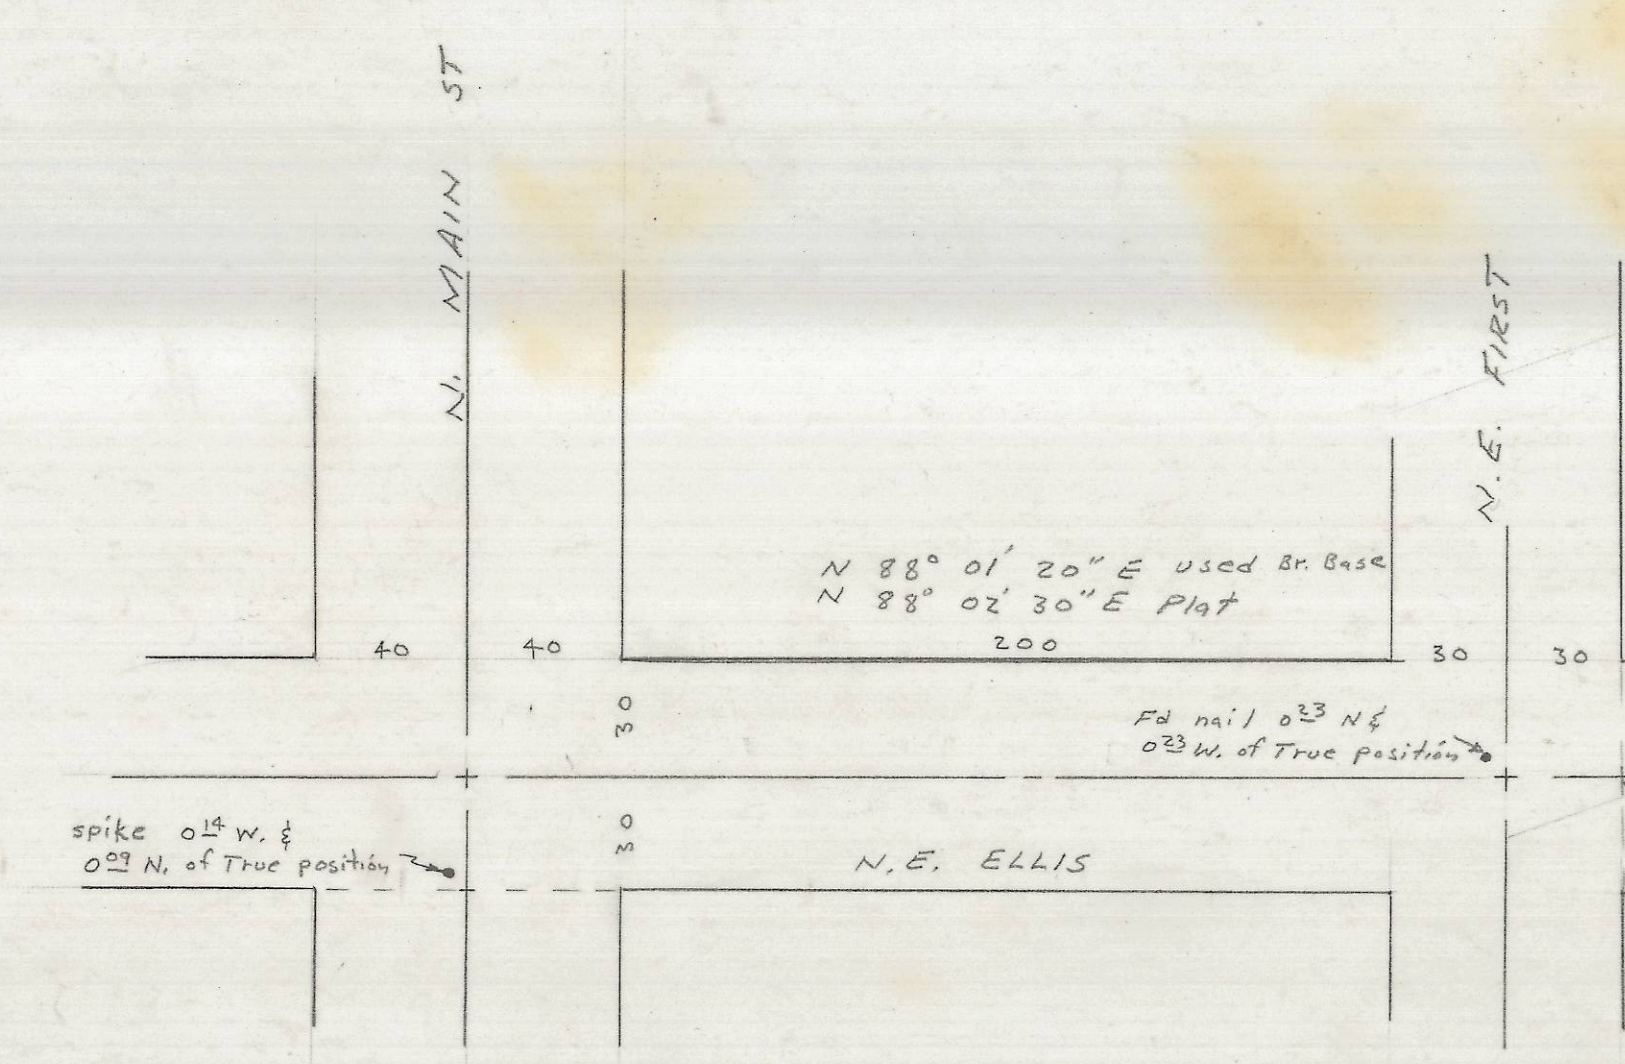

RECEIVED BY  
 Umatilla County Surveyor  
 Date: 5/30/13  
 Rec'd By: M.K.  
 No.: 13-155-B

This map drafted for  
 purpose of writing descriptions

HAMLEY, Dave