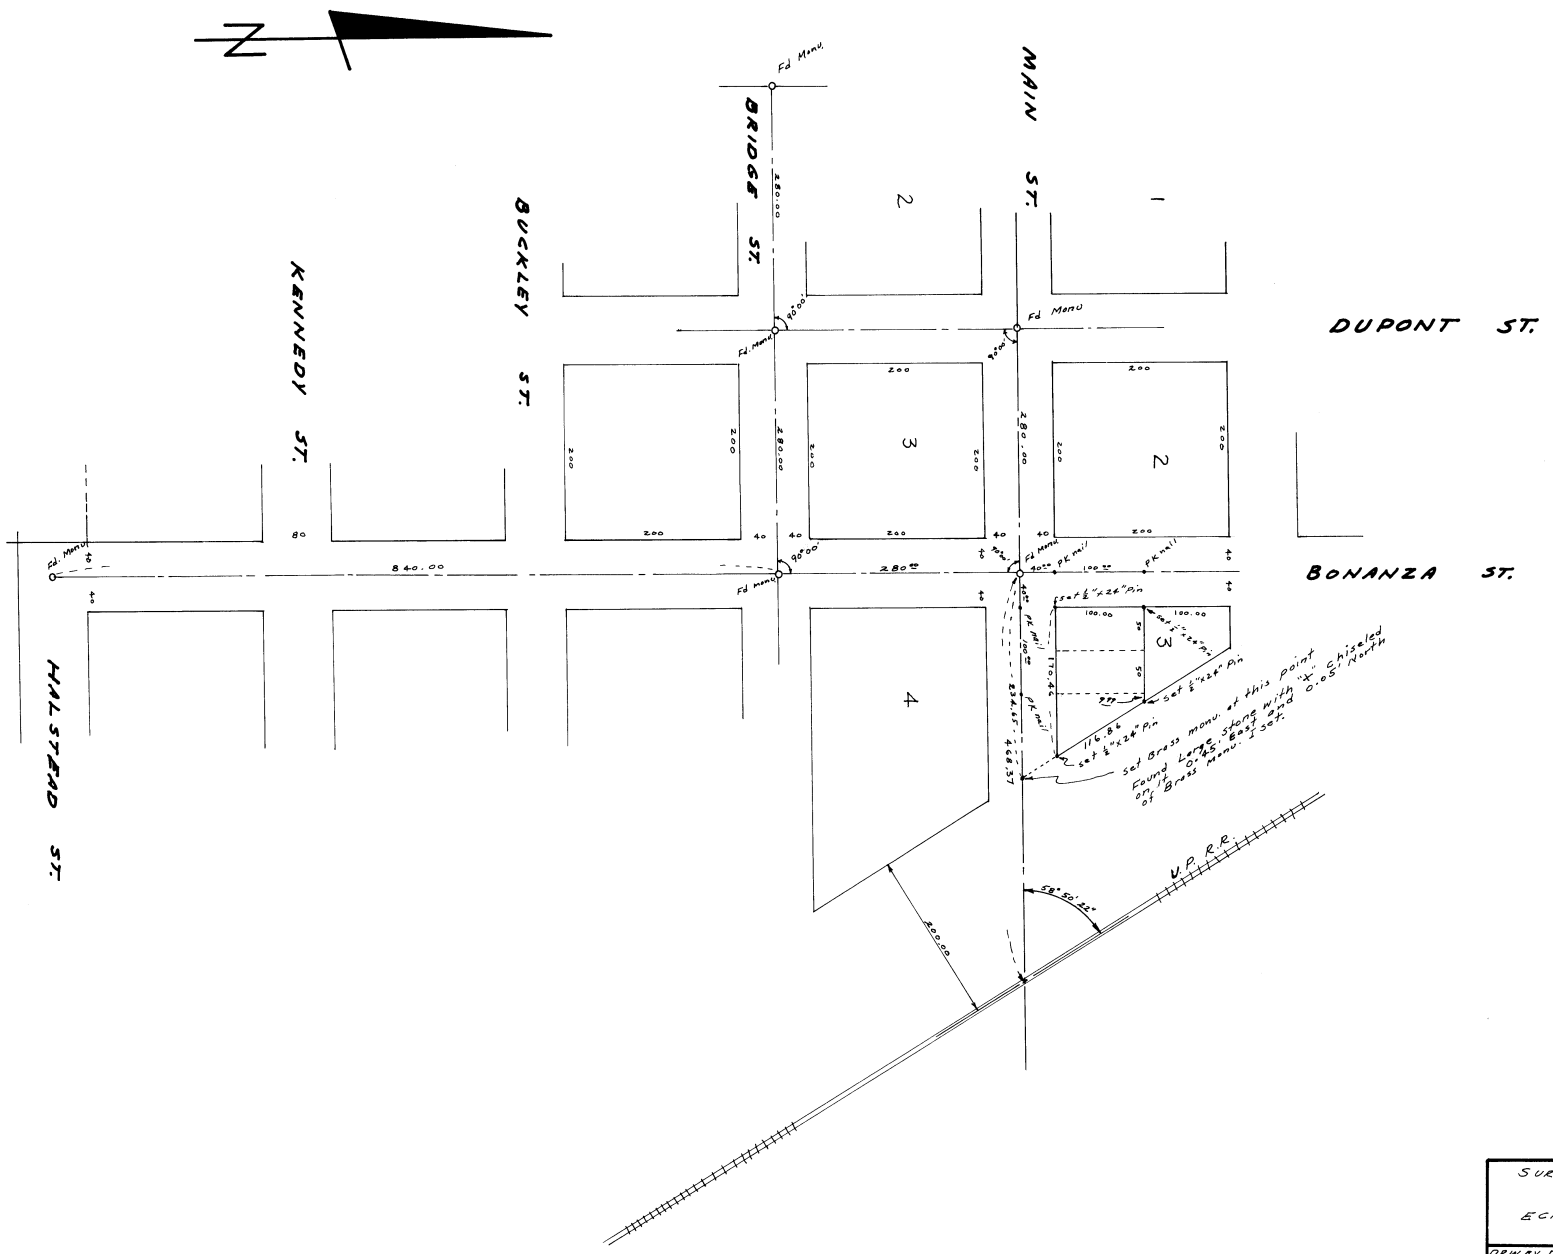

H-5-B

REGISTERED PROFESSIONAL ENGINEER
8408
Donald L. Staebler
OREGON

163N-19

SURVEY FOR ECHO FIRE DISTRICT
ECHO, OREGON

DRW BY DLS.	MARCH 19, 1971	SCALE 1"= 100'

DONALD L. STAEBLER
CONSULTING ENGINEER
P.O. BOX 91
PENDLETON OREGON

H-5-B