


SECTION 4, T15, R32E.W.M.

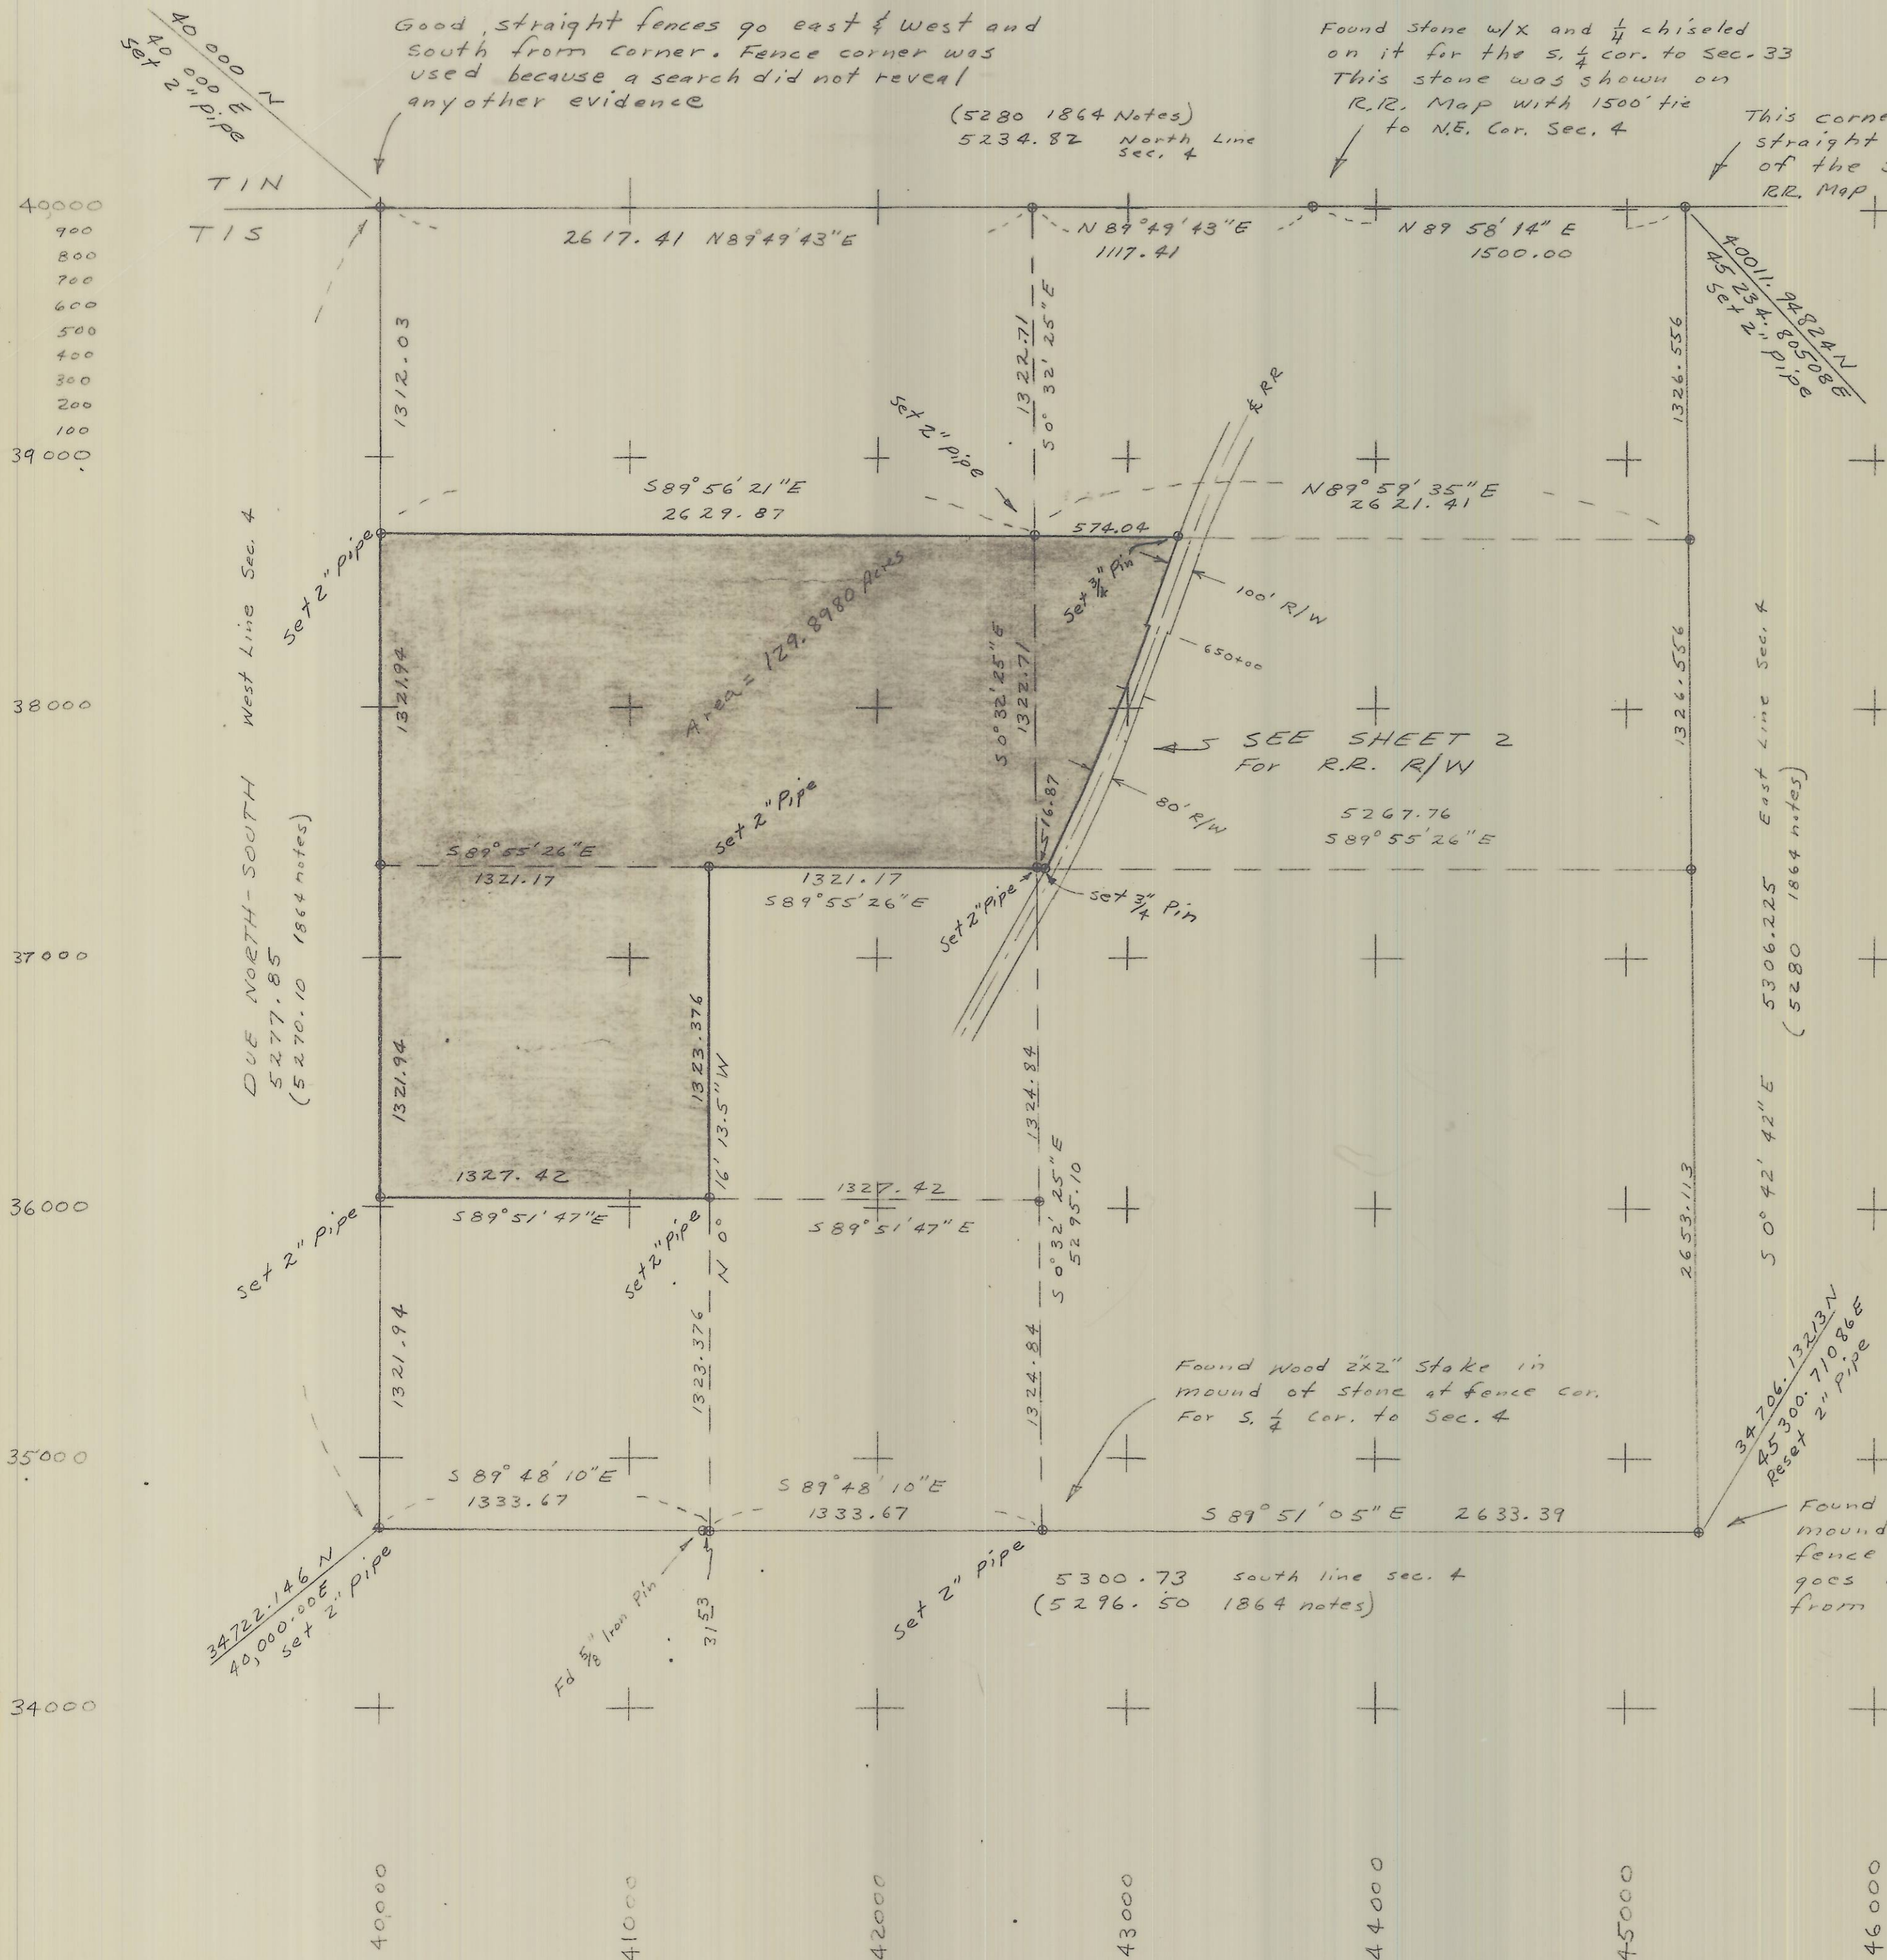

Good, straight fences go east & west and south from corner. Fence corner was used because a search did not reveal any other evidence

Found stone w/x and $\frac{1}{4}$ chiseled on it for the S. $\frac{1}{4}$ cor. to Sec. 33 This stone was shown on R.R. Map with 1500' tie to N.E. Cor. Sec. 4


This corner was set on very straight fence line 1500' East of the stone as shown on R.R. Map

(5280 1864 Notes) 5234.82 North Line Sec. 4

SCALE : 1" = 500'
DATE : 12-29-73

NOTE

1. Bearing Base is West line of section 4 is Due North-South
2. For information on west line of railroad right of way see sheet 2
3. All Pipes or Pins set are at least 30" long

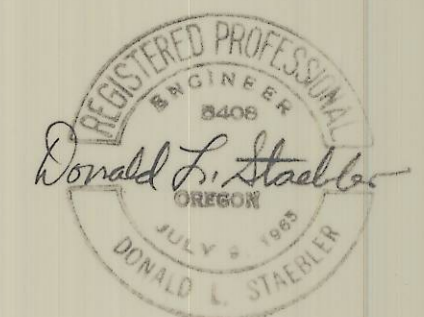

LAND SURVEY FOR
U.S. GYPSUM COMPANY
OF PILOT ROCK, OREGON
SECTION 4, T15, R32E.W.M.

SCALE 1" = 500' DATE 12-29-73

DONALD L. STAEBLER
CONSULTING ENGINEER
P.O. BOX 91
PENDLETON, OREGON
97801