


- ① B. TOSCH
- ② M. McDOWELL
- ③ B. EASTON
- ④ J. LaHUE

CERTIFICATION

I, G. DENNIS EDWARDS A REGISTERED PROFESSIONAL LAND SURVEYOR HEREBY CERTIFY THAT ON 11/28/75 A SURVEY WAS STARTED AND COMPLETED ON 12/4/75 OF THE LANDS SHOWN HEREON BY ME OR UNDER MY DIRECTION THAT THE PROPERTY CORNERS ARE MARKED AS SHOWN, AND THAT THIS MAP IS A TRUE AND ACCURATE REPRESENTATION OF SAID SURVEY.

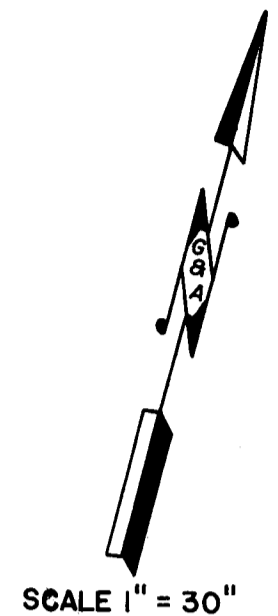

REGISTERED PROFESSIONAL LAND SURVEYOR
G. Dennis Edwards
 OREGON
 JULY 16, 1971
 G. DENNIS EDWARDS
 951

LEGEND

---	LOT LINE
---	PROPERTY LINE
---	CENTER LINE
•	FND. I.R.
○	SET I.R.

K-024-B
 BLOCK 39 & 41 OF ORIGINAL TOWN, NOW CITY OF UMATILLA
 IN THE SE 1/4, NE 1/4, SEC. 8, T4N, R28E, W.M.
 UMATILLA COUNTY, OREGON

SURVEY FOR M. McDowell, B. Tosch, B. Easton, J. LaHue		
GASCHLER & ASSOCIATES		
ONTARIO, OREGON		HERMISTON, OREGON
DESIGNED BY: <i>[Signature]</i>	DRAWN BY: <i>[Signature]</i>	APPROVED BY: G.D.E.
DATE: 12/4/75	DRAWING NO. B-18	BK _____ PG _____
SHEET 1 OF 1	JOB NO. H50-2375	REVISED: