


LEGEND

- FOUND CONCRETE NAIL
- ⊙----- FOUND IRON PIN
- SET IRON PIN

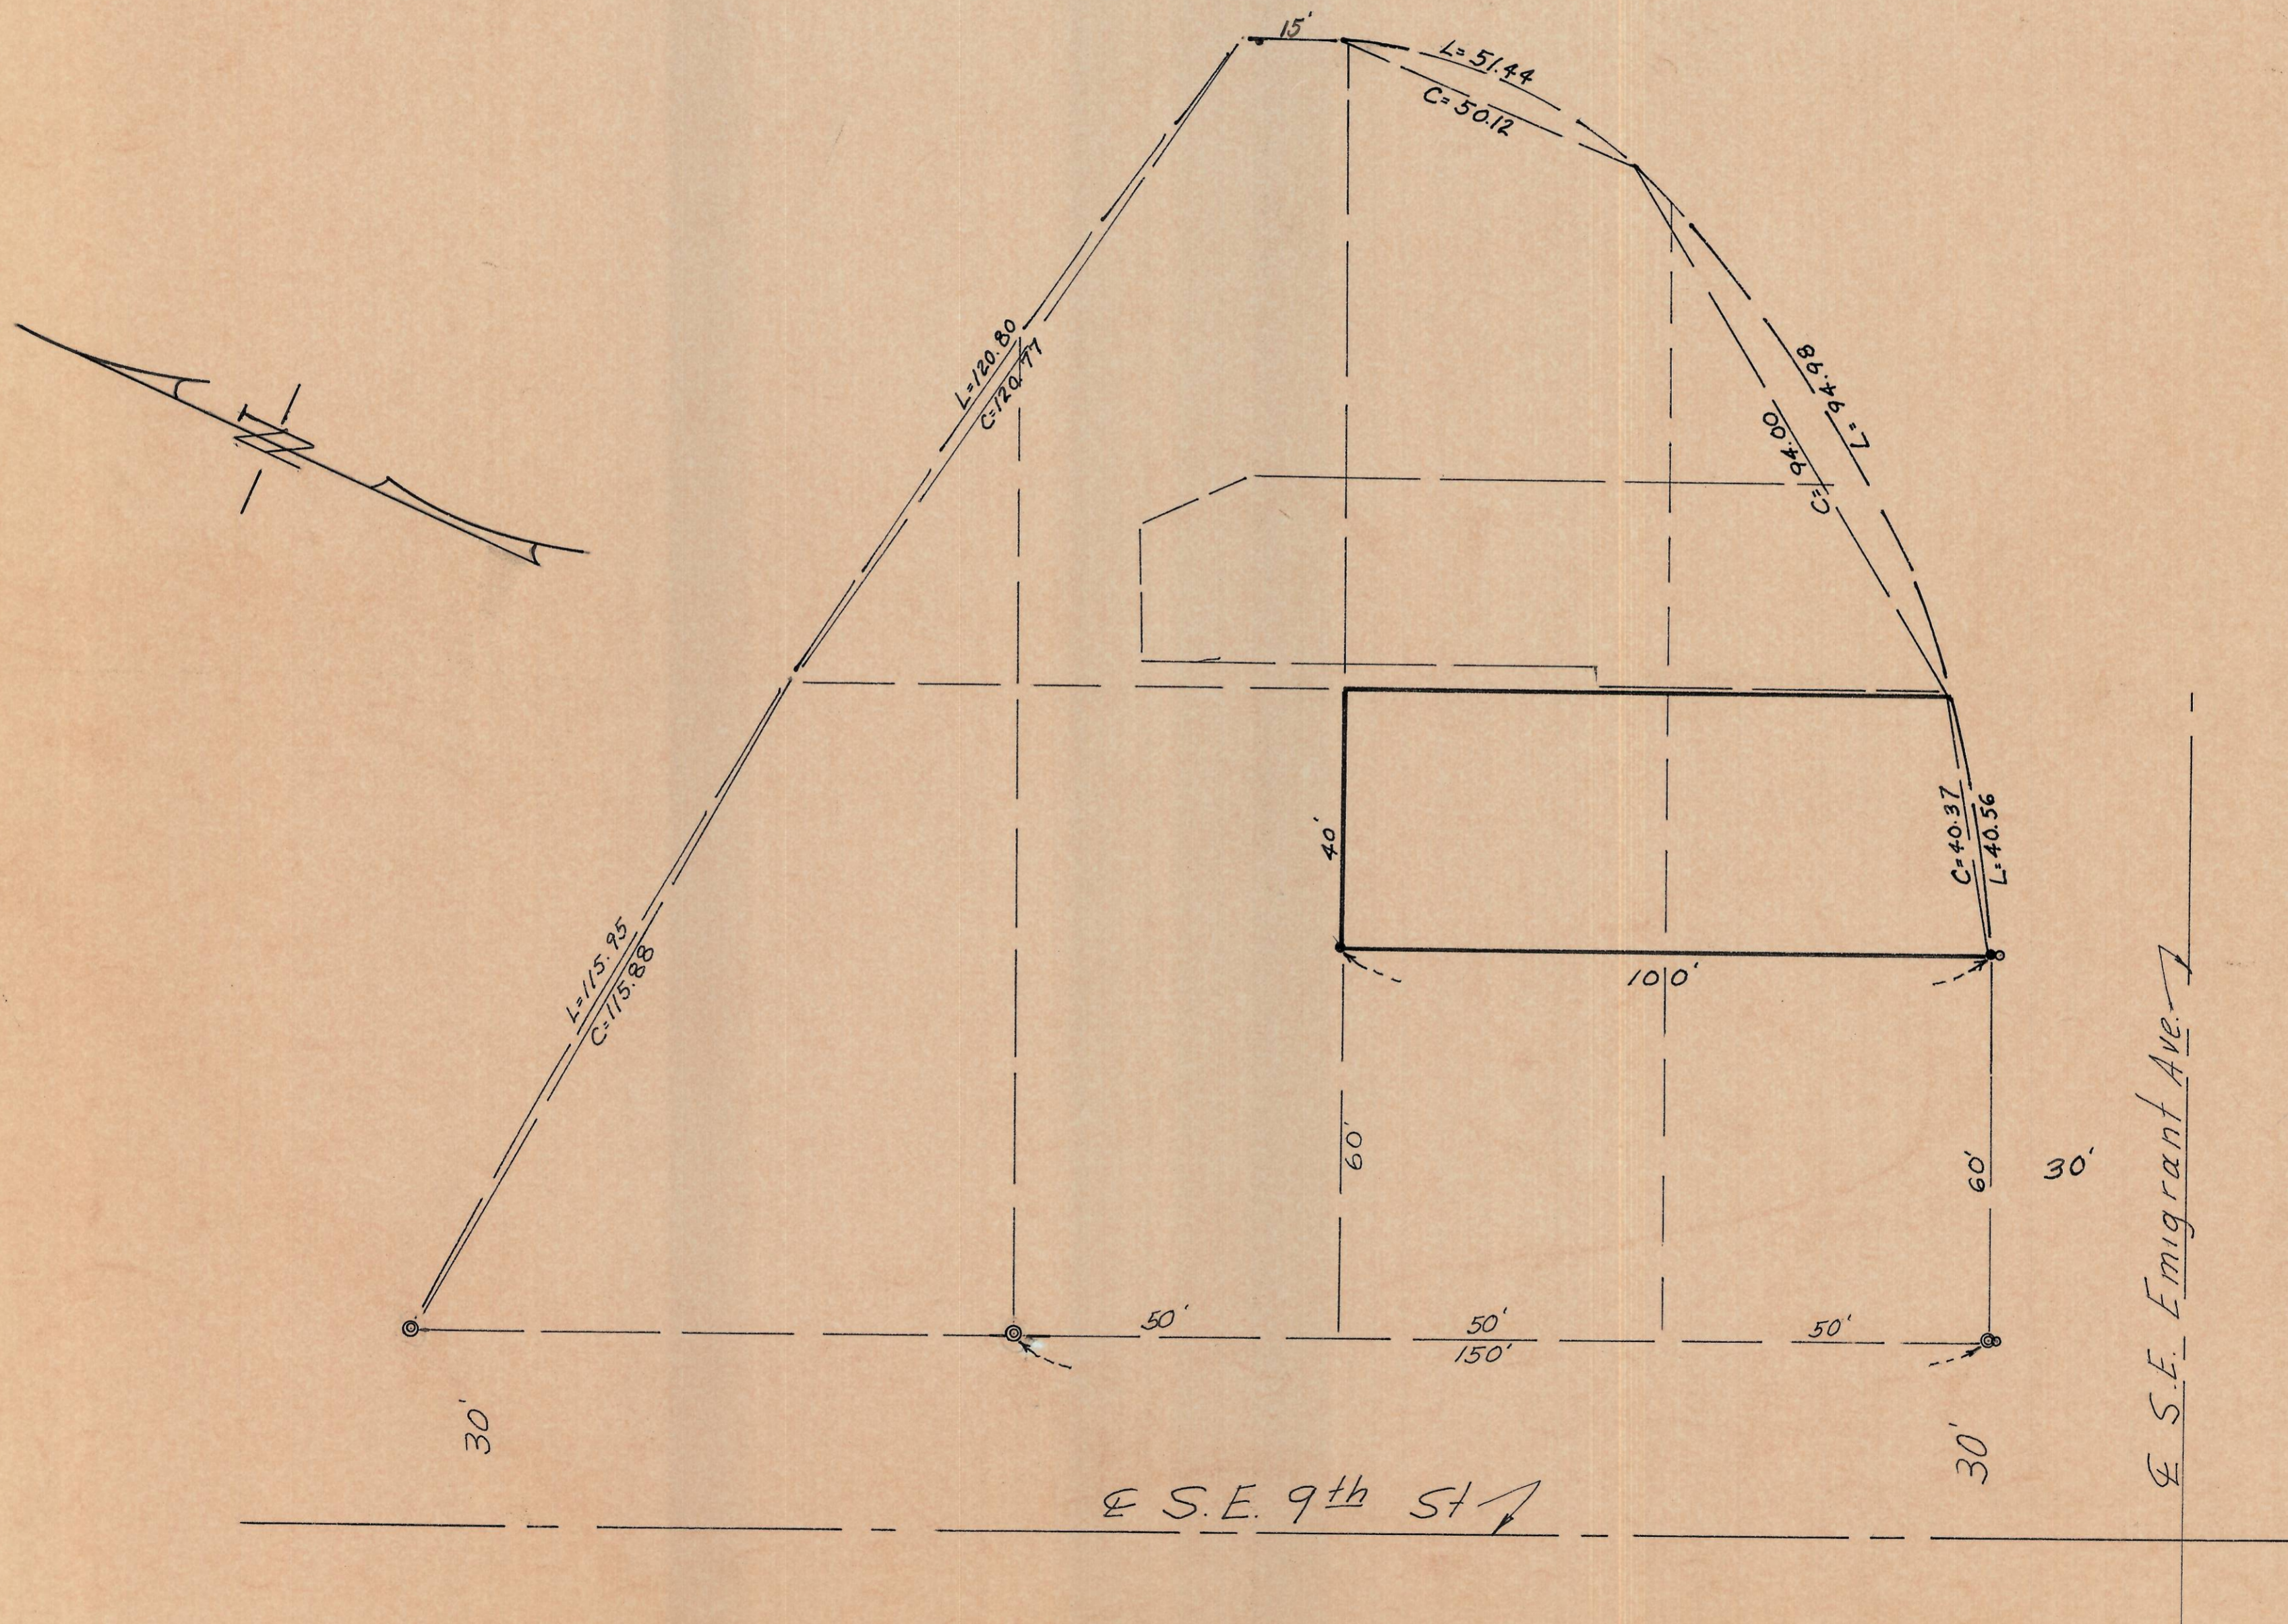

REGISTERED PROFESSIONAL LAND SURVEYOR
Ralph P. Thompson
 OREGON
 NOV 23 1966
 RALPH P. THOMPSON
 508

SURVEY FOR LES SCHWAB BLOCK 17, RESERVATION ADDN. PEND.		RALPH THOMPSON REGISTERED LAND SURVEYOR P. O. BOX 1082 - PENDLETON, ORE. 97801			
SCALE	DATE	DRN. BY	CKD. BY		
1"=20'	7-1-76	RT	RT		

L-65

L-65-B