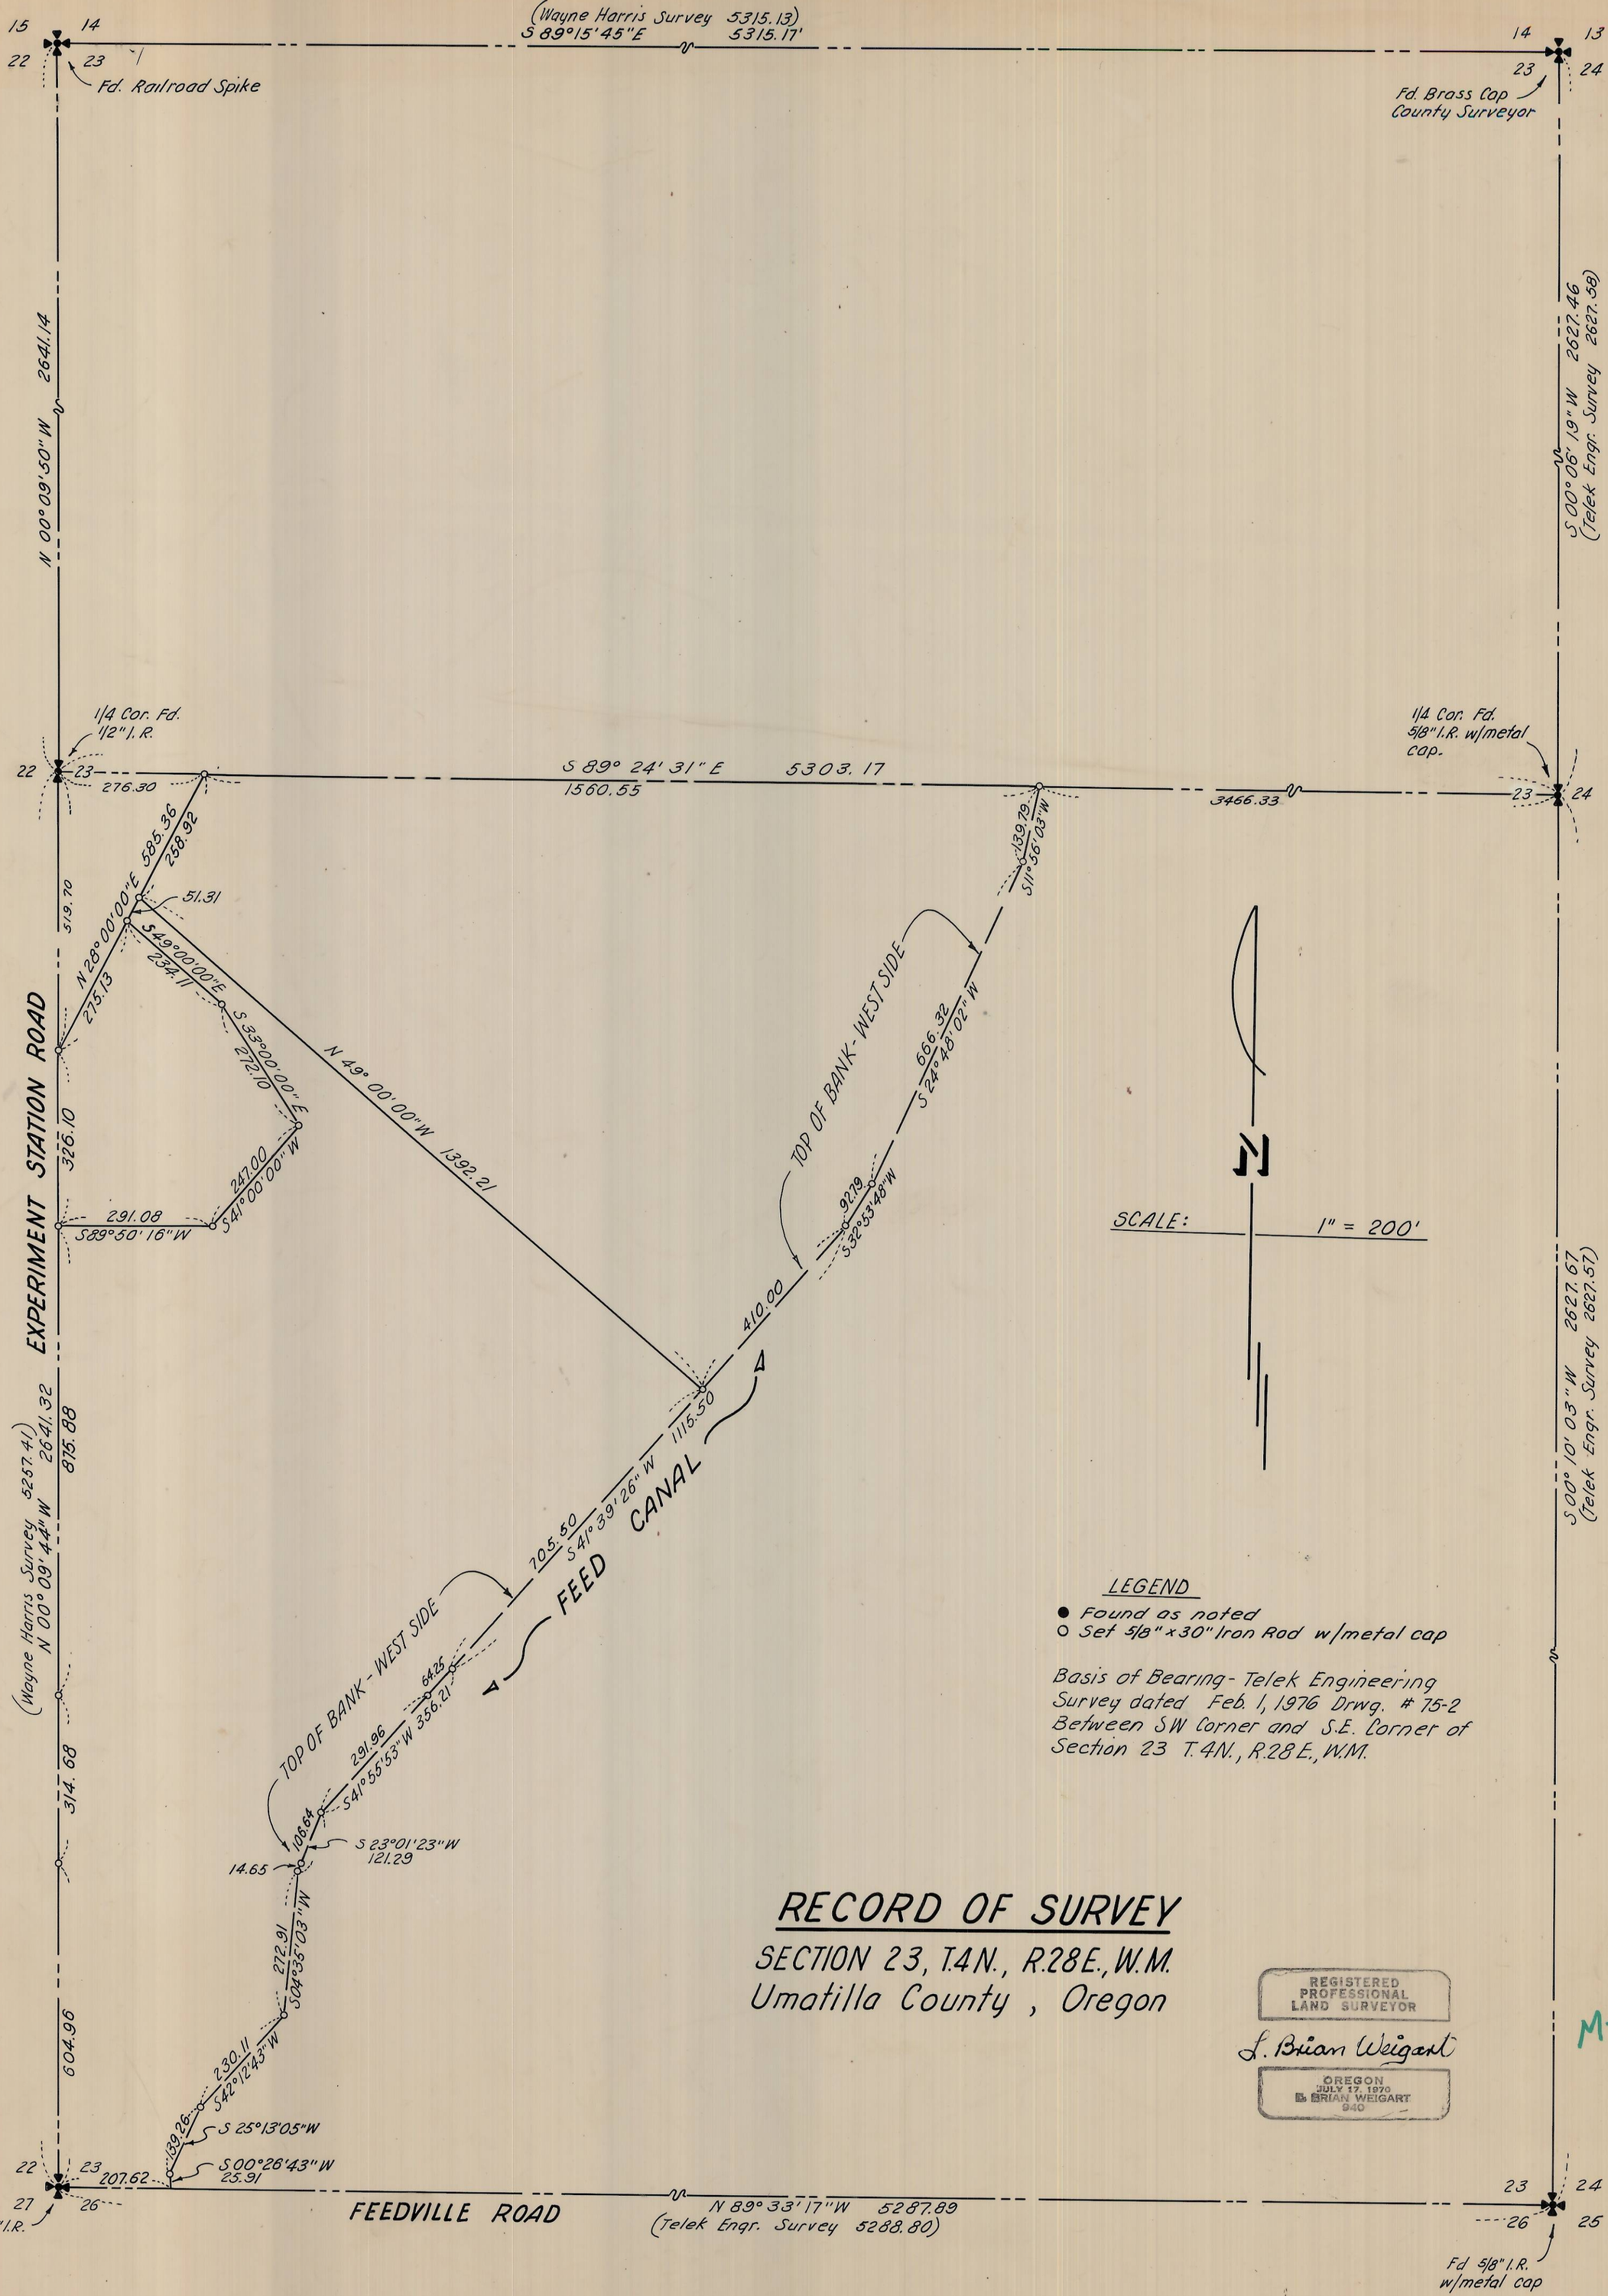

LEGEND

- ● Found as noted
- ○ Set 5/8" x 30" Iron Rod w/metal cap

Basis of Bearing - Telek Engineering Survey dated Feb. 1, 1976 Drwg. # 75-2 Between SW Corner and S.E. Corner of Section 23 T. 4N., R. 28 E., W.M.

RECORD OF SURVEY

SECTION 23, T.4N., R.28E., W.M.

Umatilla County, Oregon

REGISTERED PROFESSIONAL LAND SURVEYOR

L. Brian Weigart

OREGON JULY 17, 1970 L. BRIAN WEIGART 940

M-67

FOR: CIRCLE "C"

FIELD SURVEY: APRIL 28, 1977

BAKER ASSOCIATES INC.
Planning Engineering Surveying

10550 S.W. ALLEN BLVD.
SUITE 223 - (503) 643-9410
BEAVERTON OREGON
97005

DRAWN:	R. Black
APP'D:	L.B.W
DATE:	5-25-77
JOB NO.:	44202

M-67-8