



Bearings based  
on County  
Survey Records  
for Umatilla  
County Oregon

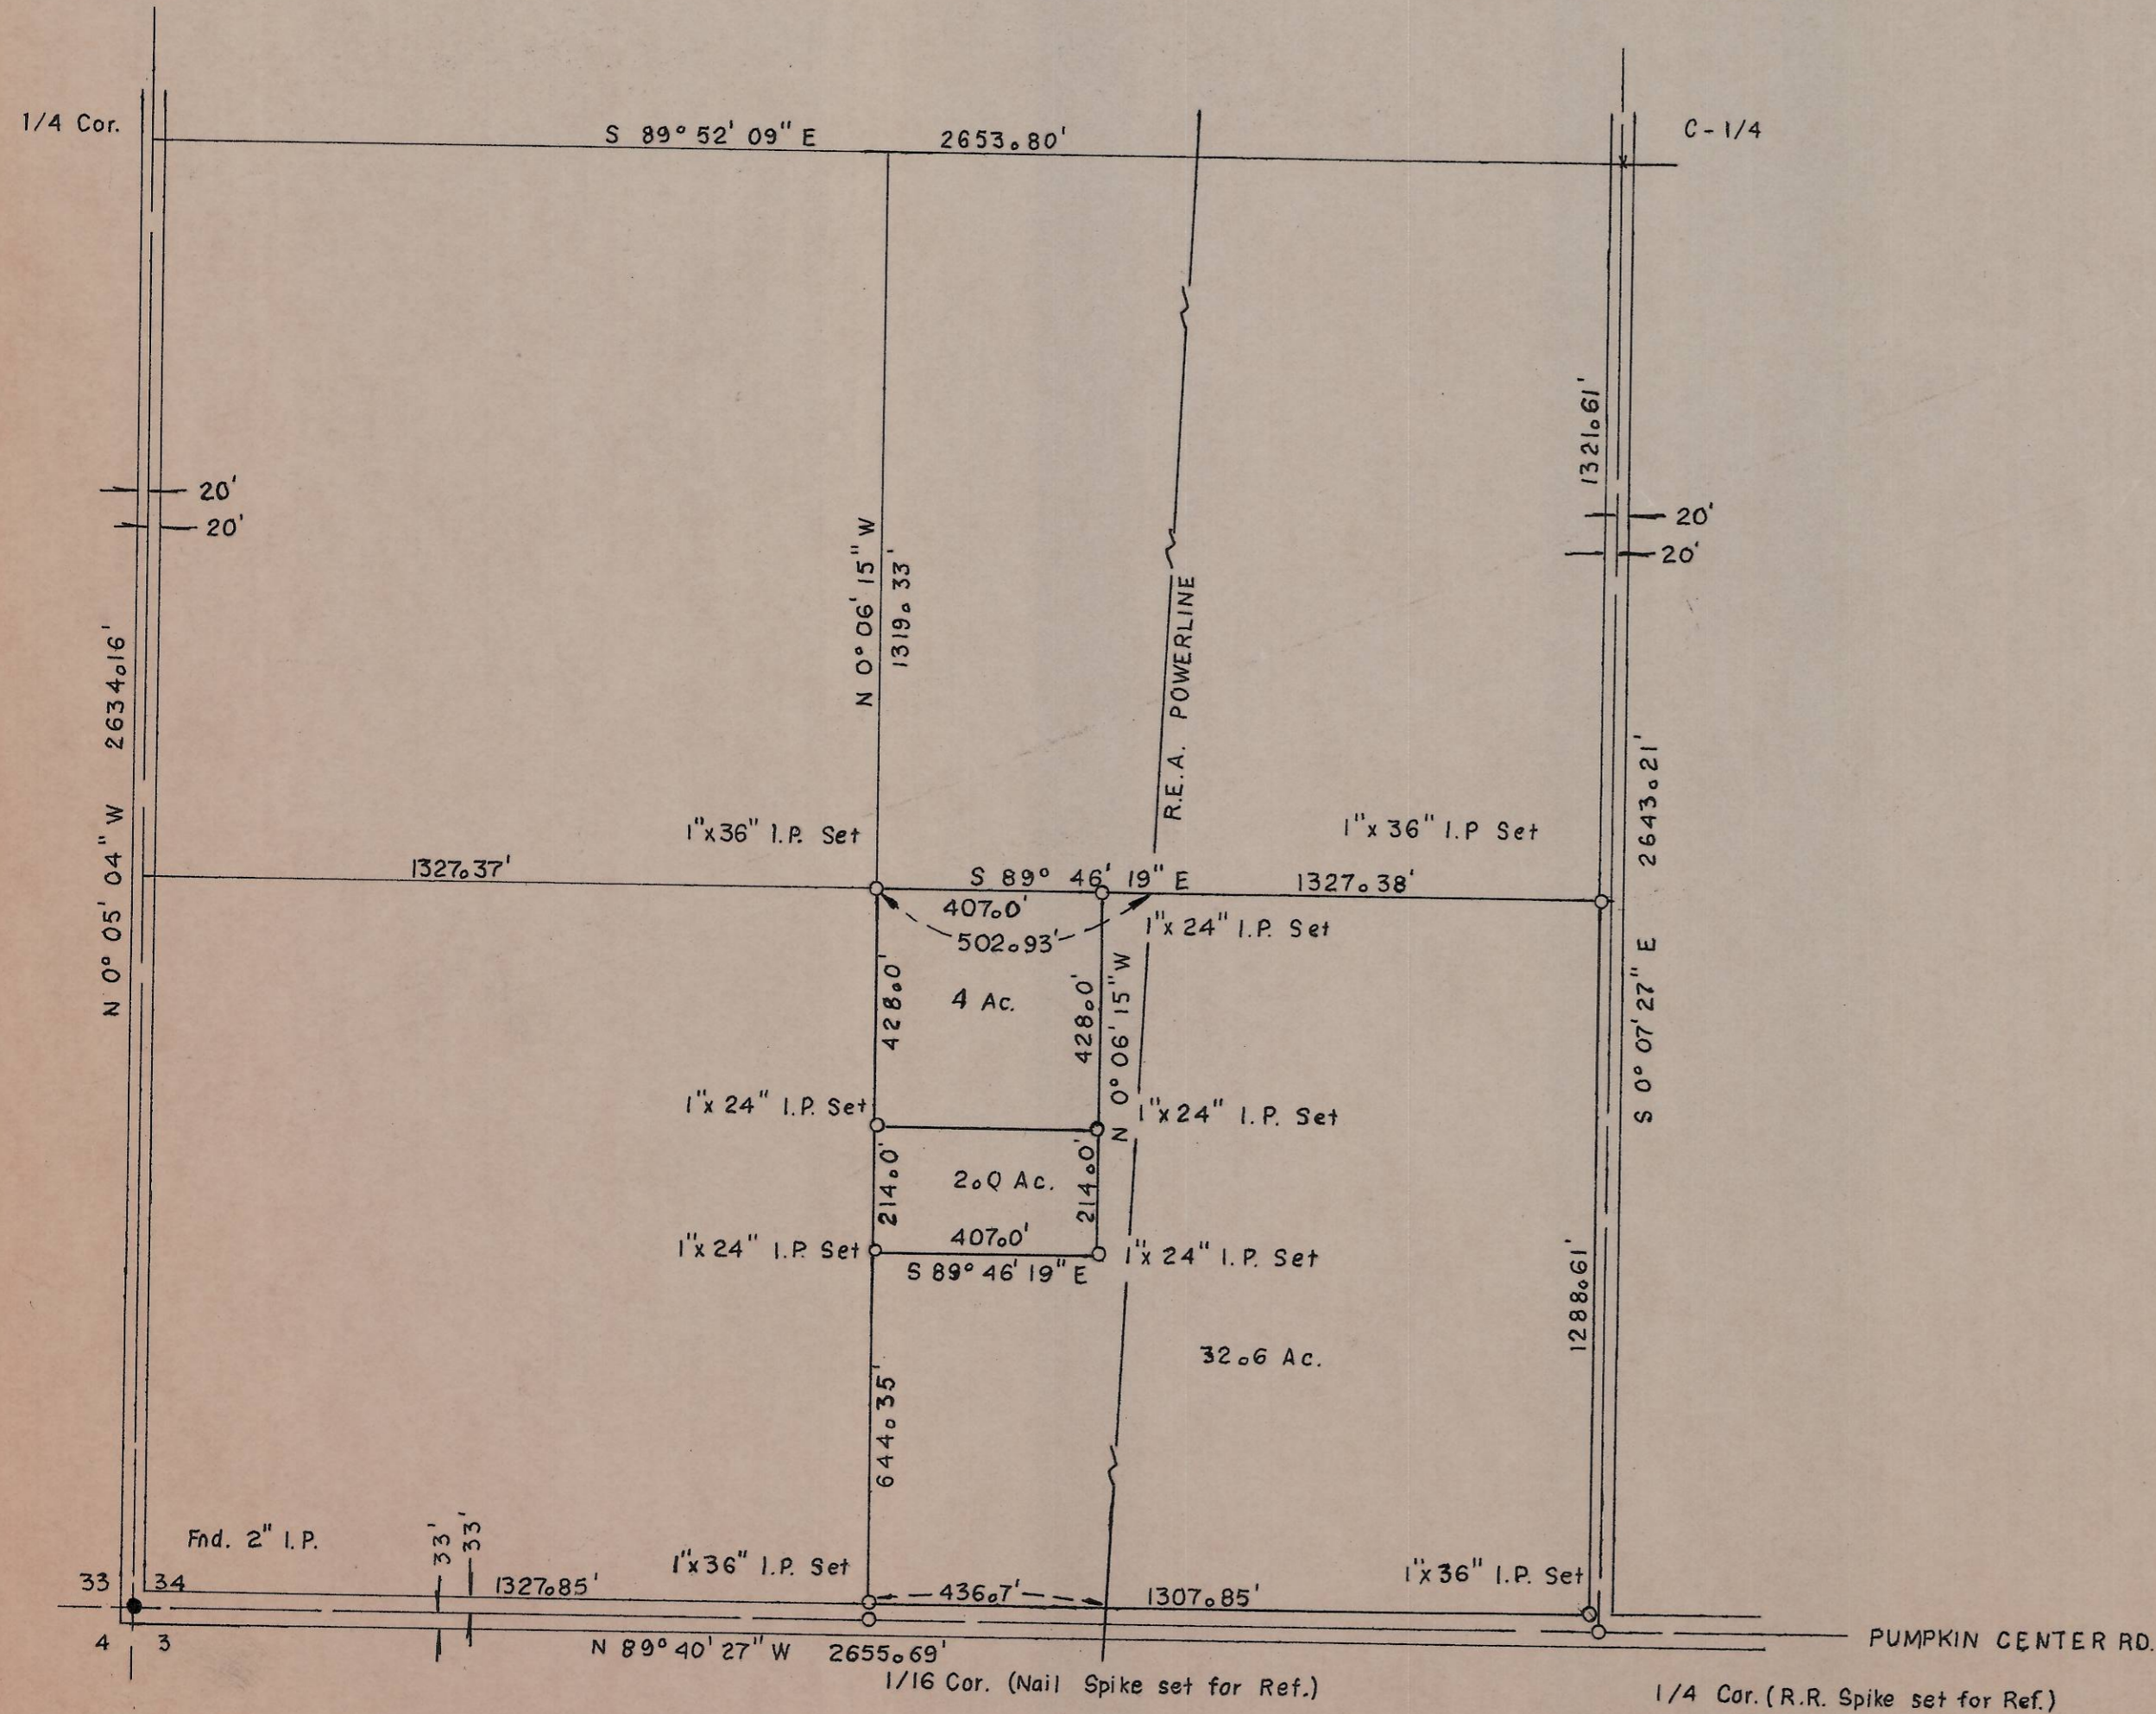


SW 1/4 SEC. 34  
scale: 1" = 300'

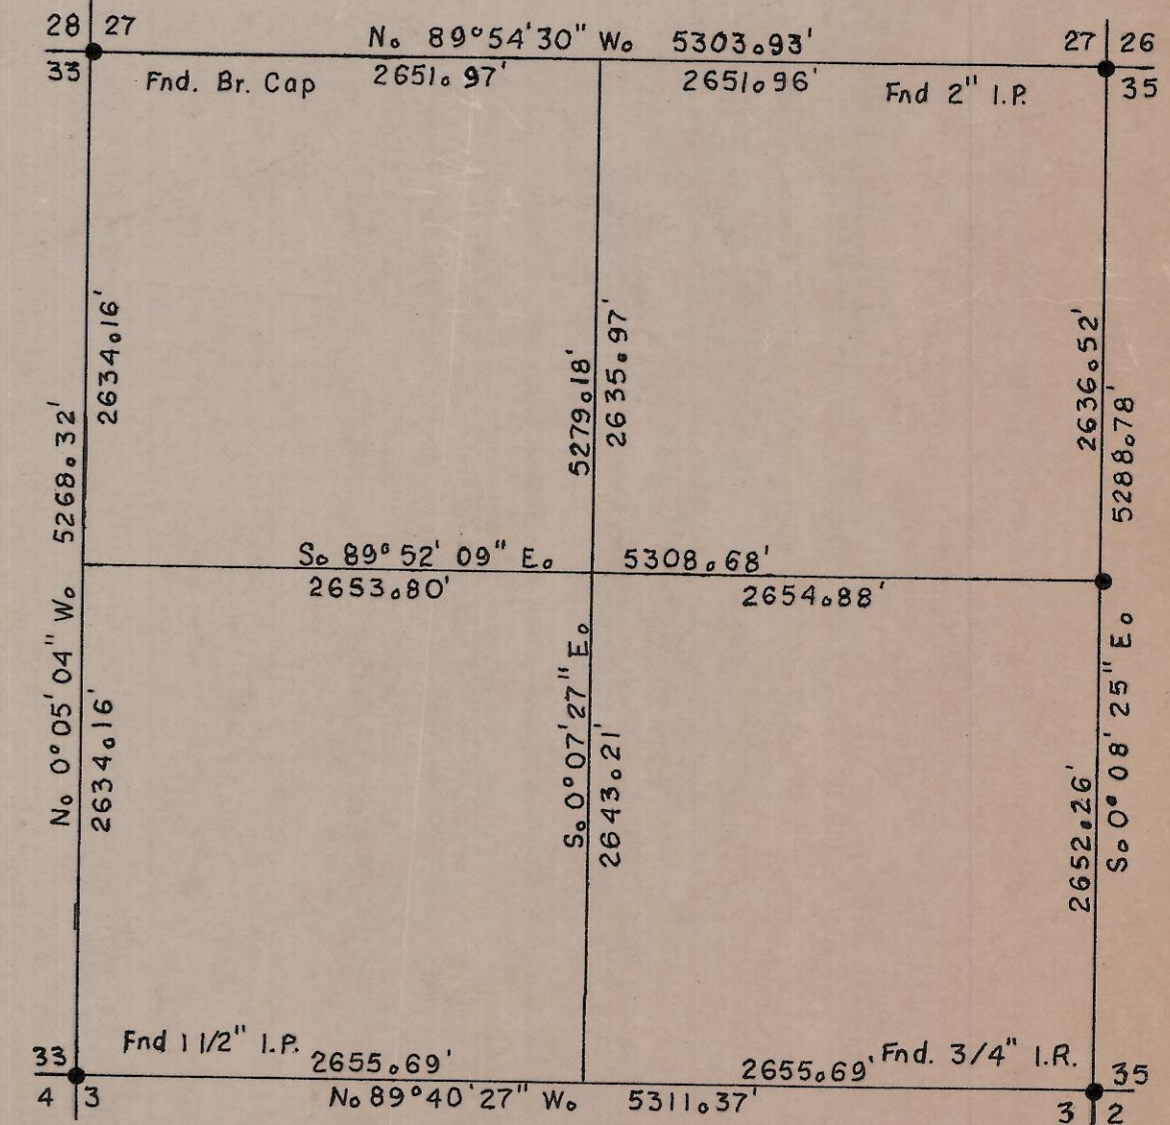

SECTION 34, T. 5 N., R. 28 E., W.M.

- o Reference found
- o Steel pipe set (except as noted)

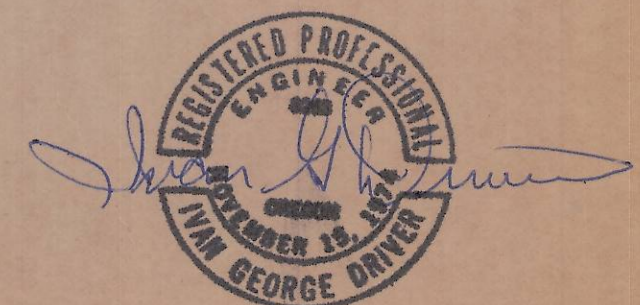

SURVEY FOR MERLE HAMILTON		
scale: SHOWN	LACE ENTERPRISES INC.	dwg by: TGD
date: 10-30-76	PO BOX 1539 UMATILLA, ORE 97882	
		043076

M-106-B