

S.E. 1/4, Section 32, T4N, R29E, W.M.  
Scale: 1"=500'

**Notes:**

- 1) "Stanfield Orchard outlots" Plat re-established by proportion based on the S.E. 1/4 of Section 32.
- 2) Average proportion width was used for Coe Ave. and Sloan Street.
- 3) Bearings are based on Krumbein Engineering Co. Survey for Brown, dated January 9, 1978, dated 78-2A.


**Legend:**

- ( ) - denotes Plat distance
- - denotes 5/8" iron pin set

REGISTERED  
PROFESSIONAL  
LAND SURVEYOR

James H. Buichman

1978  
JAMES H. BUICHMAN

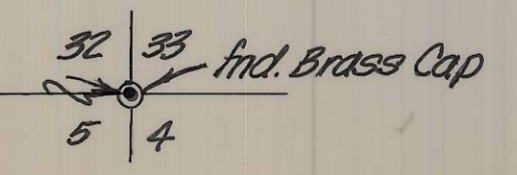

<b>K</b> KRUMBEIN ENGINEERING CO. ENGINEERS - SURVEYORS - PLANNERS 221 S. Main, Pendleton, Oregon	SCALE 1"=50'
	DATE May 24, 1978
Survey for <b>FLOYD BROOKS</b> S.E. 1/4, Section 32, T4N, R29E, W.M.	DRN BY D.S.
	CKD BY J.H.B.
	PRNG NO. # 78-416

P-104

78-136