


RALPH THOMPSON
SURVEYOR

E 2 SE 4 SECTION 16
Tp 3 N., R 29 E. W.M.

Scale 1 inch = 200 feet

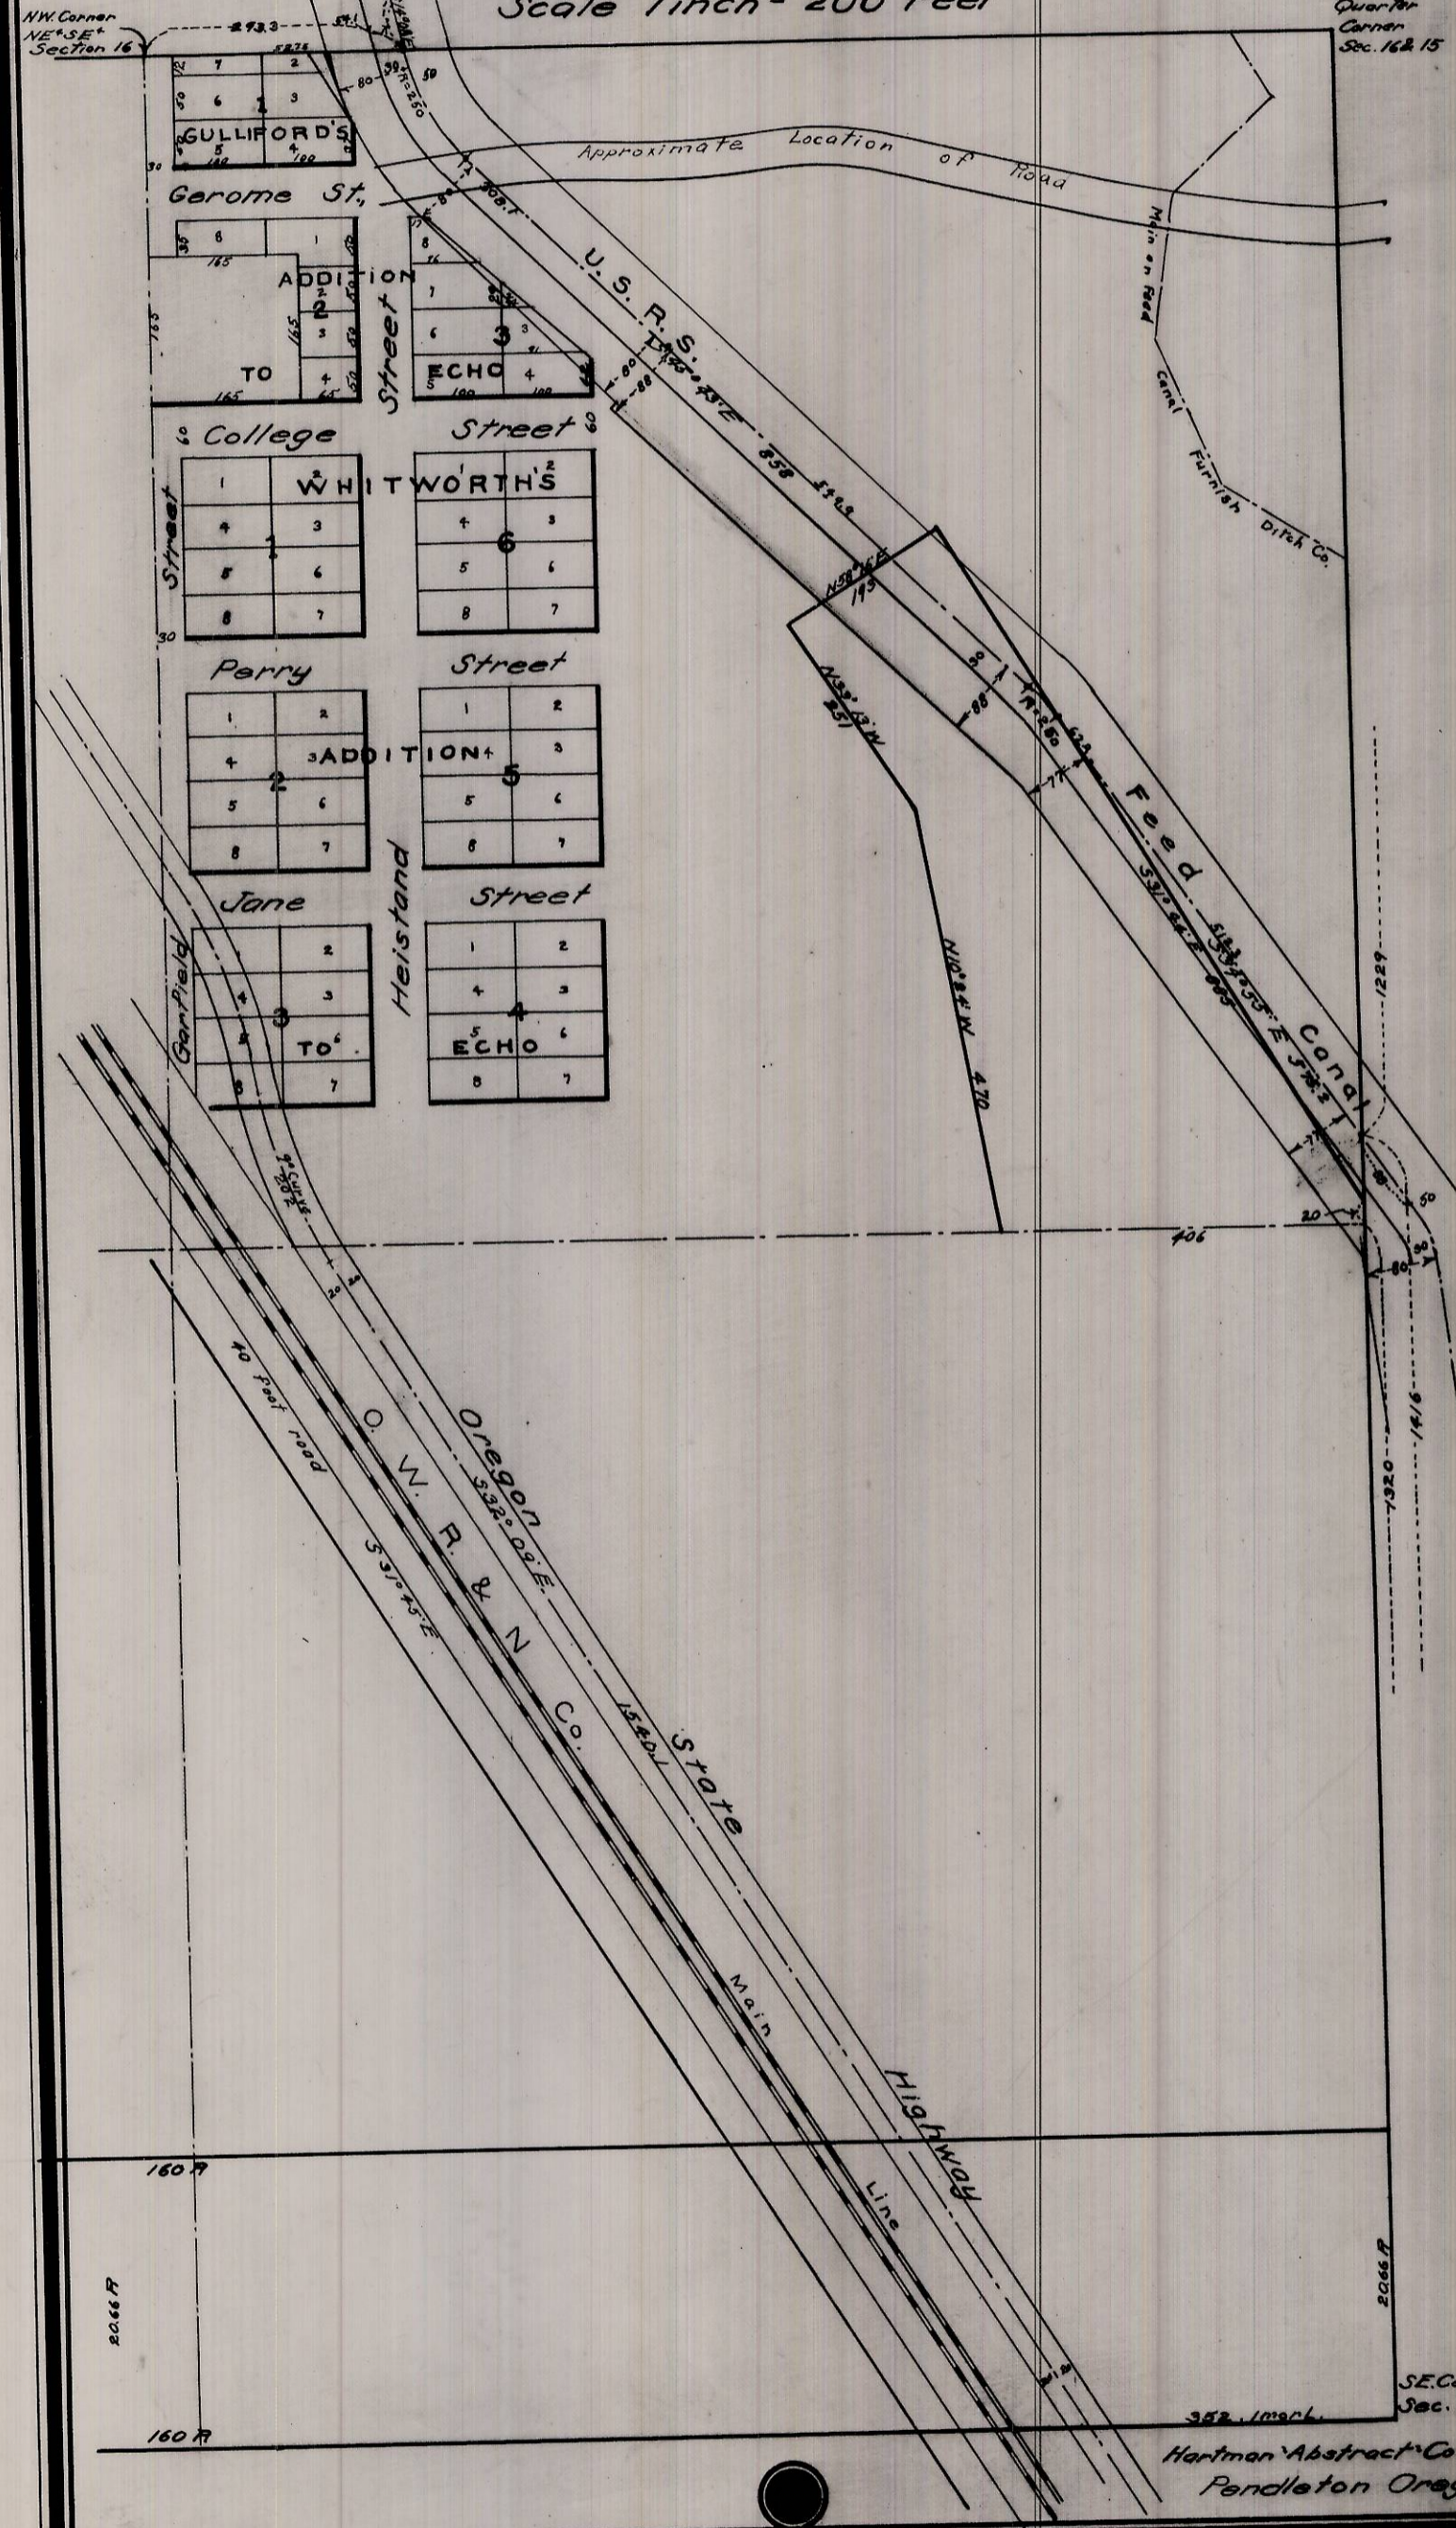


RALPH THOMPSON
COUNTY SURVEYOR

Part of
ECHO
UMATILLA County OREGON
SECTION 16 Tp 3 N., R 29 E. W.M.

Scale 1 inch = 60 feet

Hartman Abstract Co.,
Pendleton Oregon.

DEPOT
O. W. R. R. & N. Co.
ECHO
GROUNDS

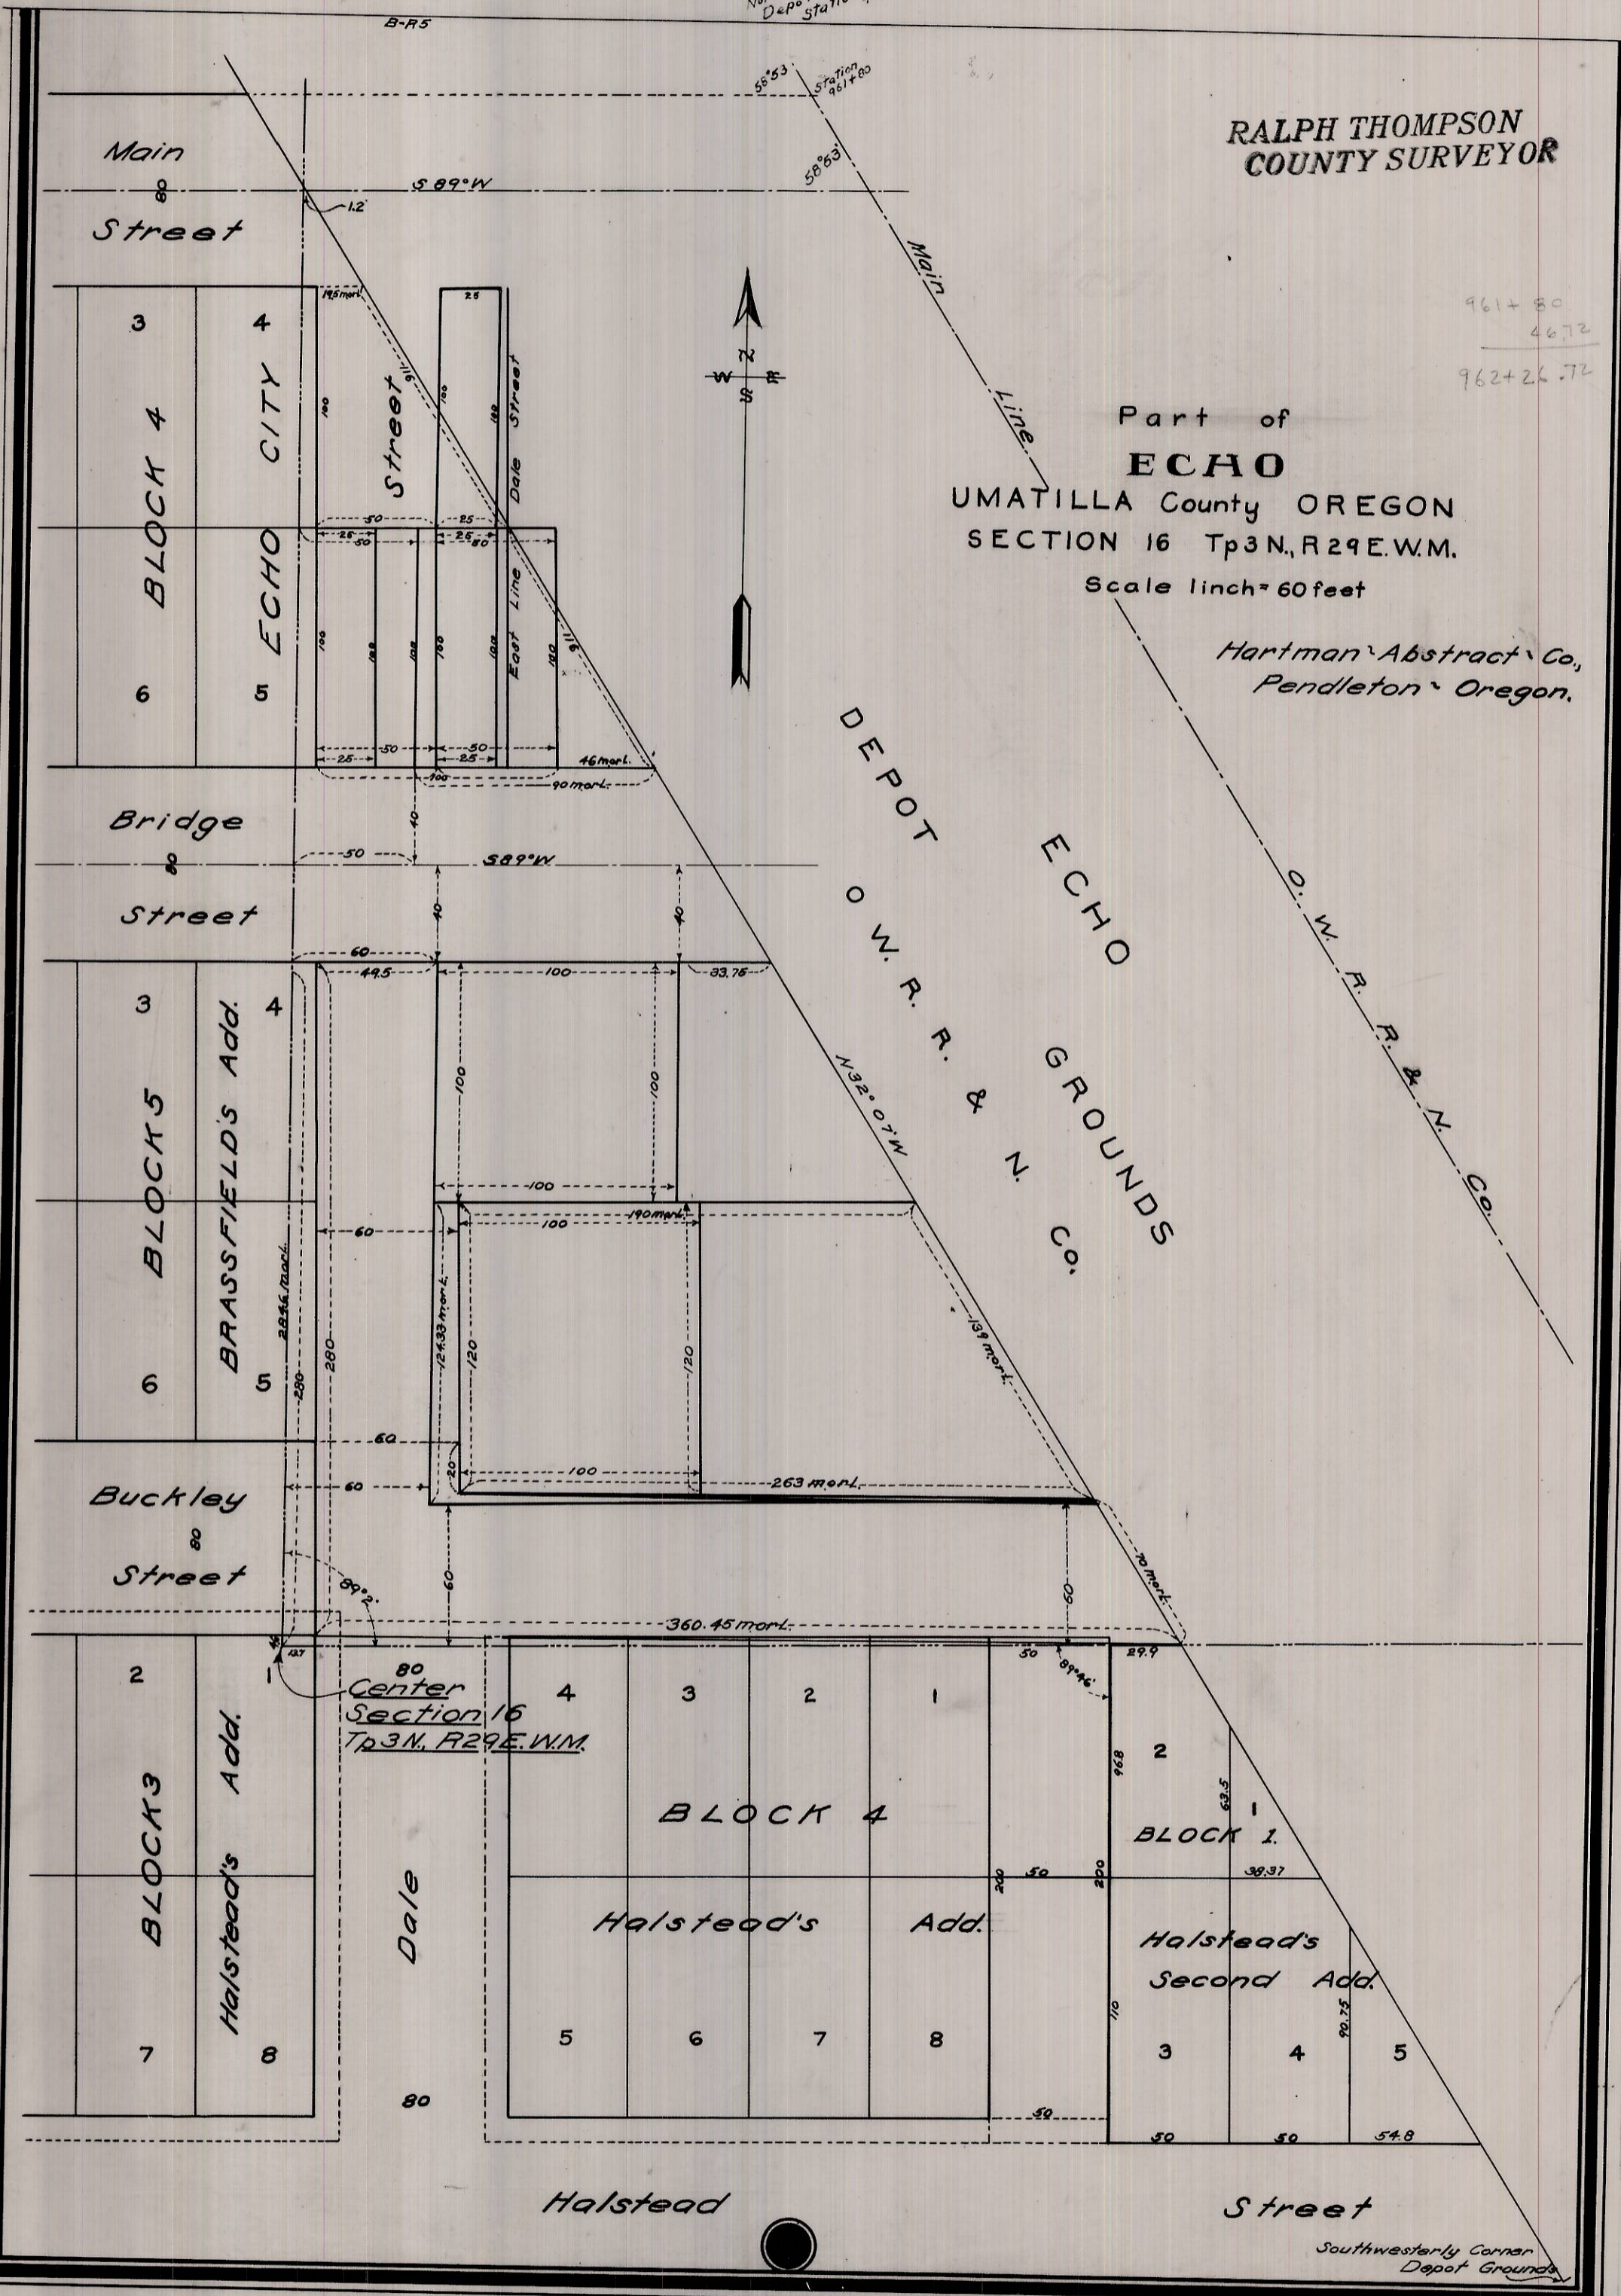

Q-32-B