


S. E. BYERS AVE.

S. MAIN ST.


S. E. 1st ST.

S. E. COURT ST.

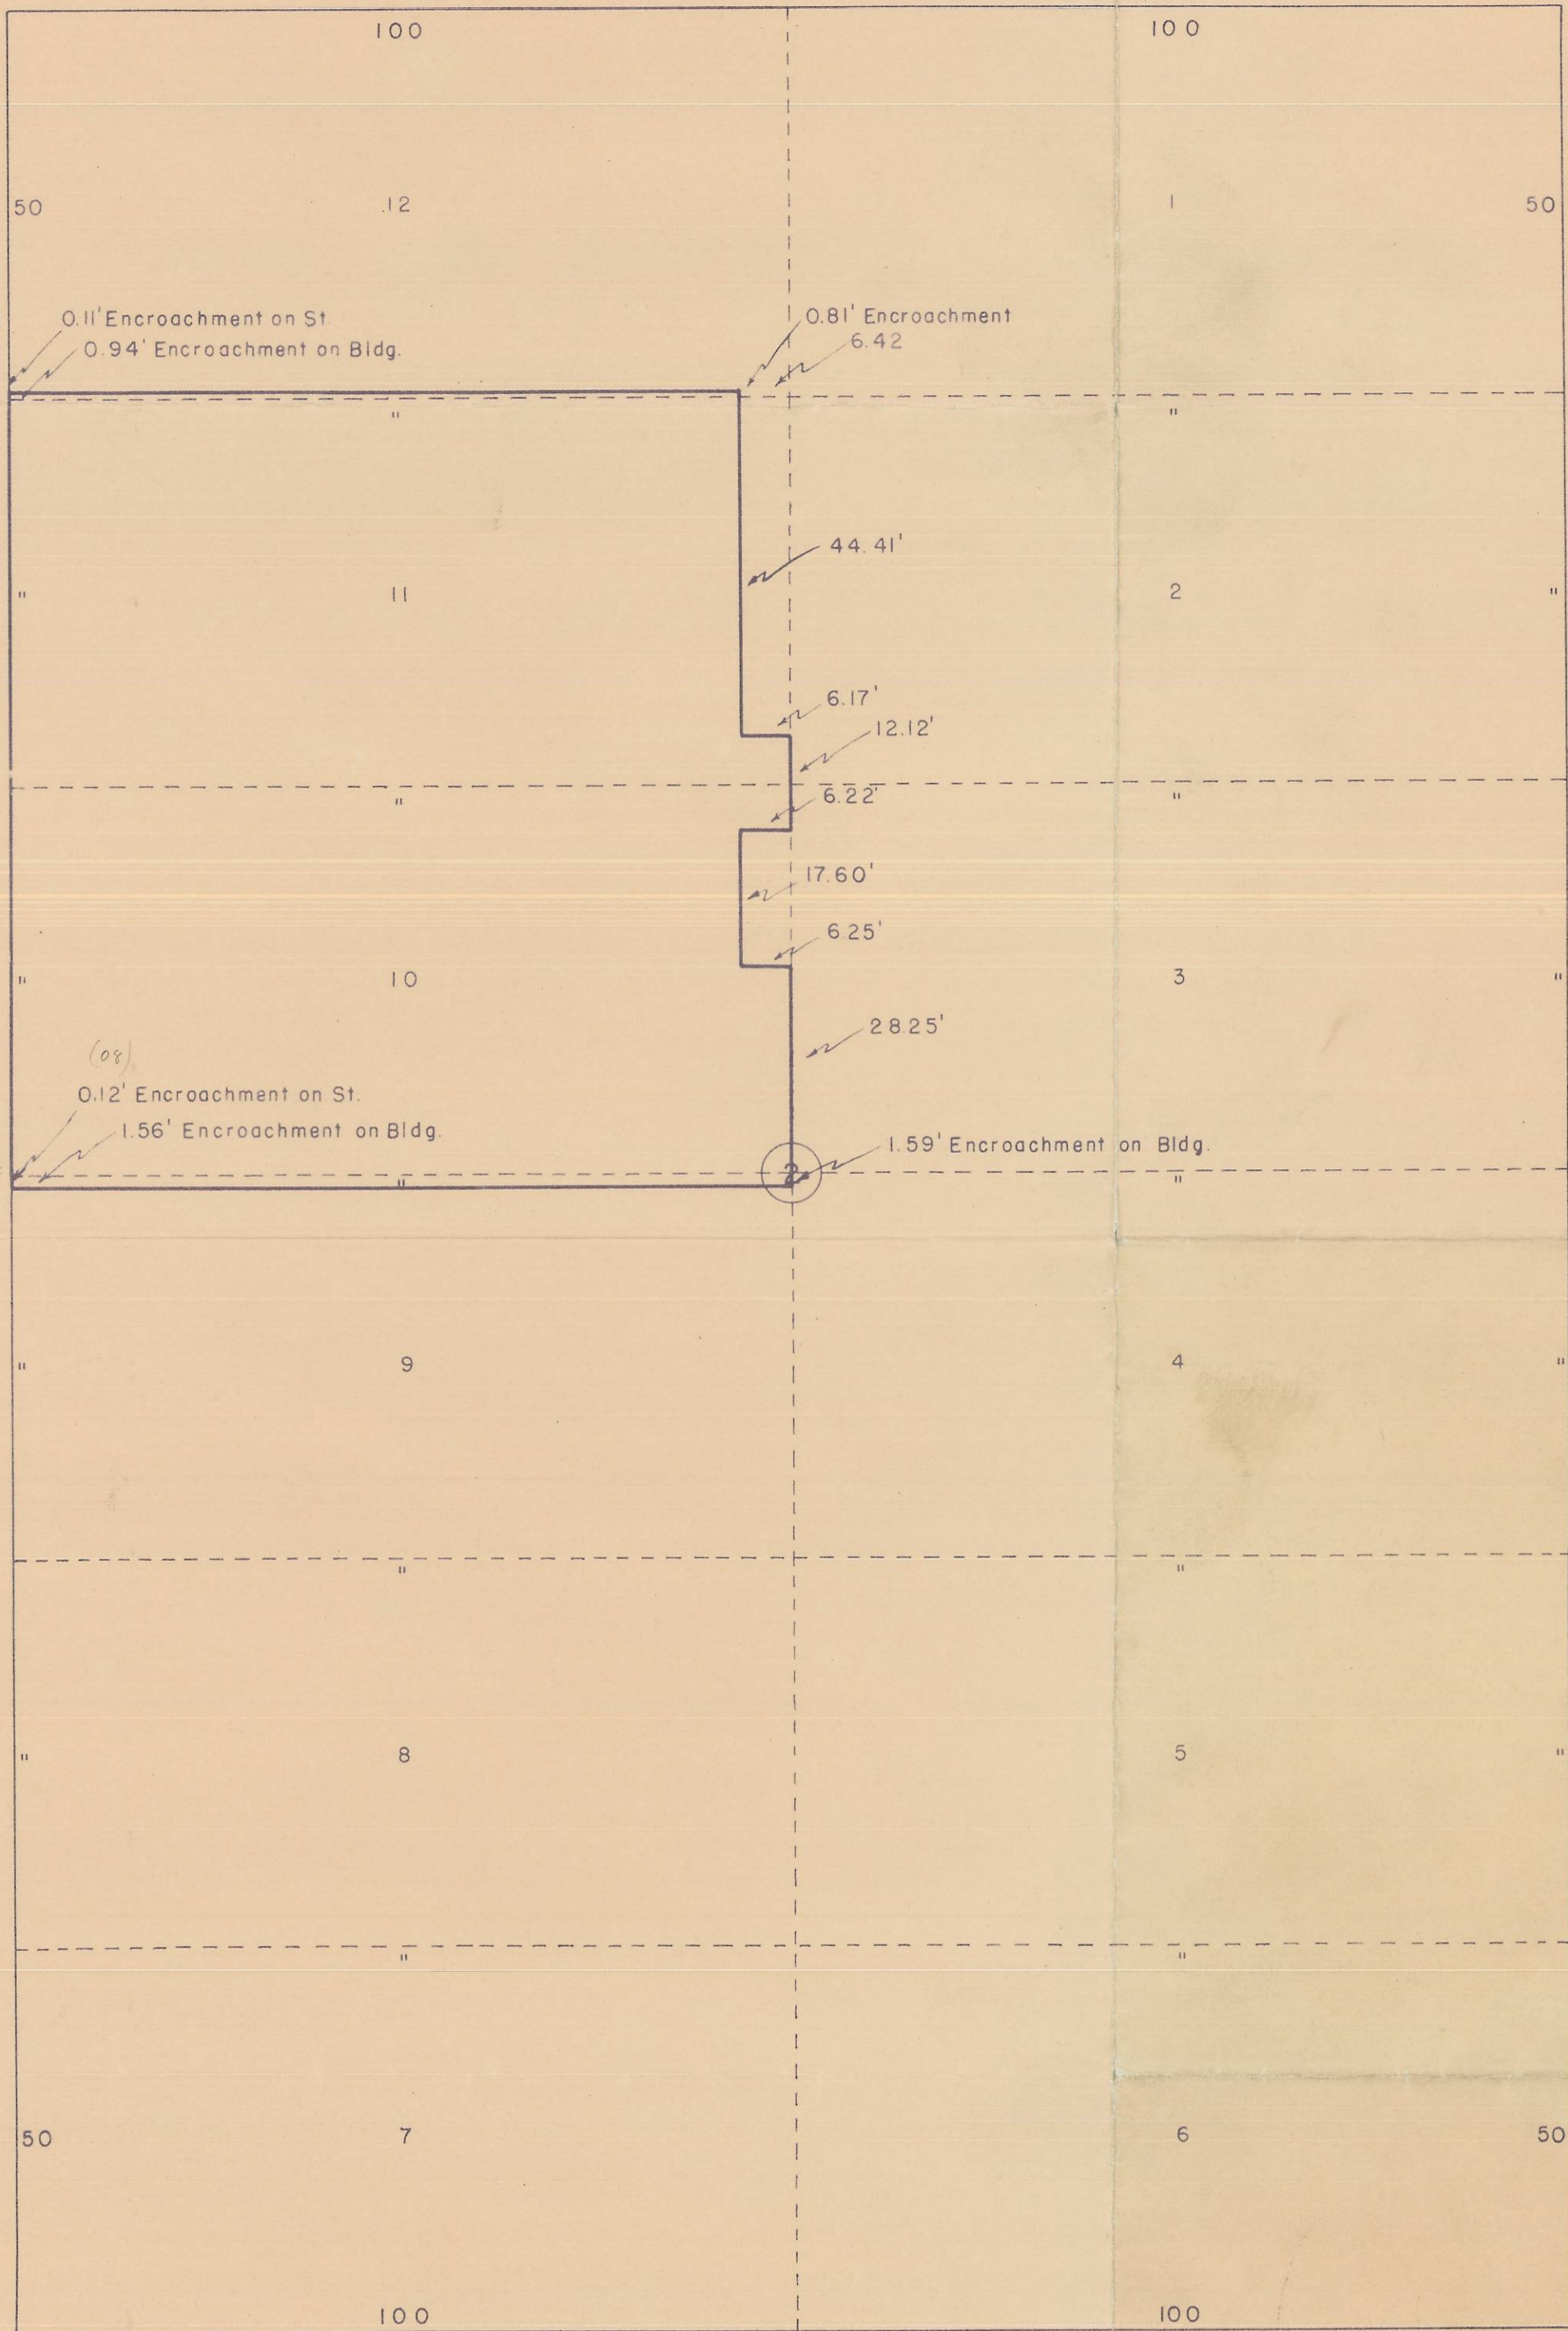

SURVEY
 OF
 LOTS 3, 10, & 11, BLOCK 2
 ORIGINAL TOWN
 PENDLETON, OREGON
 SHOWING
 BLDG. LOCATION
 FOR
STANGIER BROS.

Q-276-B
2N 32 10 A

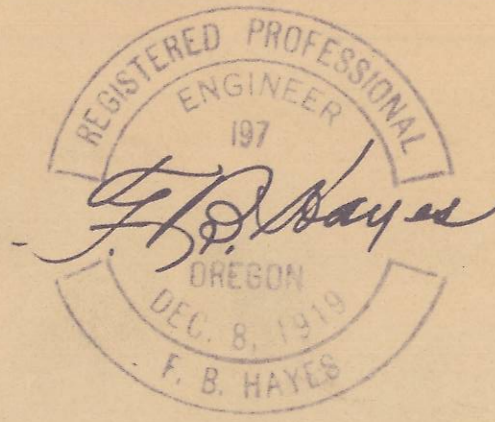

MEYER CO

Q-276-B