


D = 3°
Δ = 4°33'

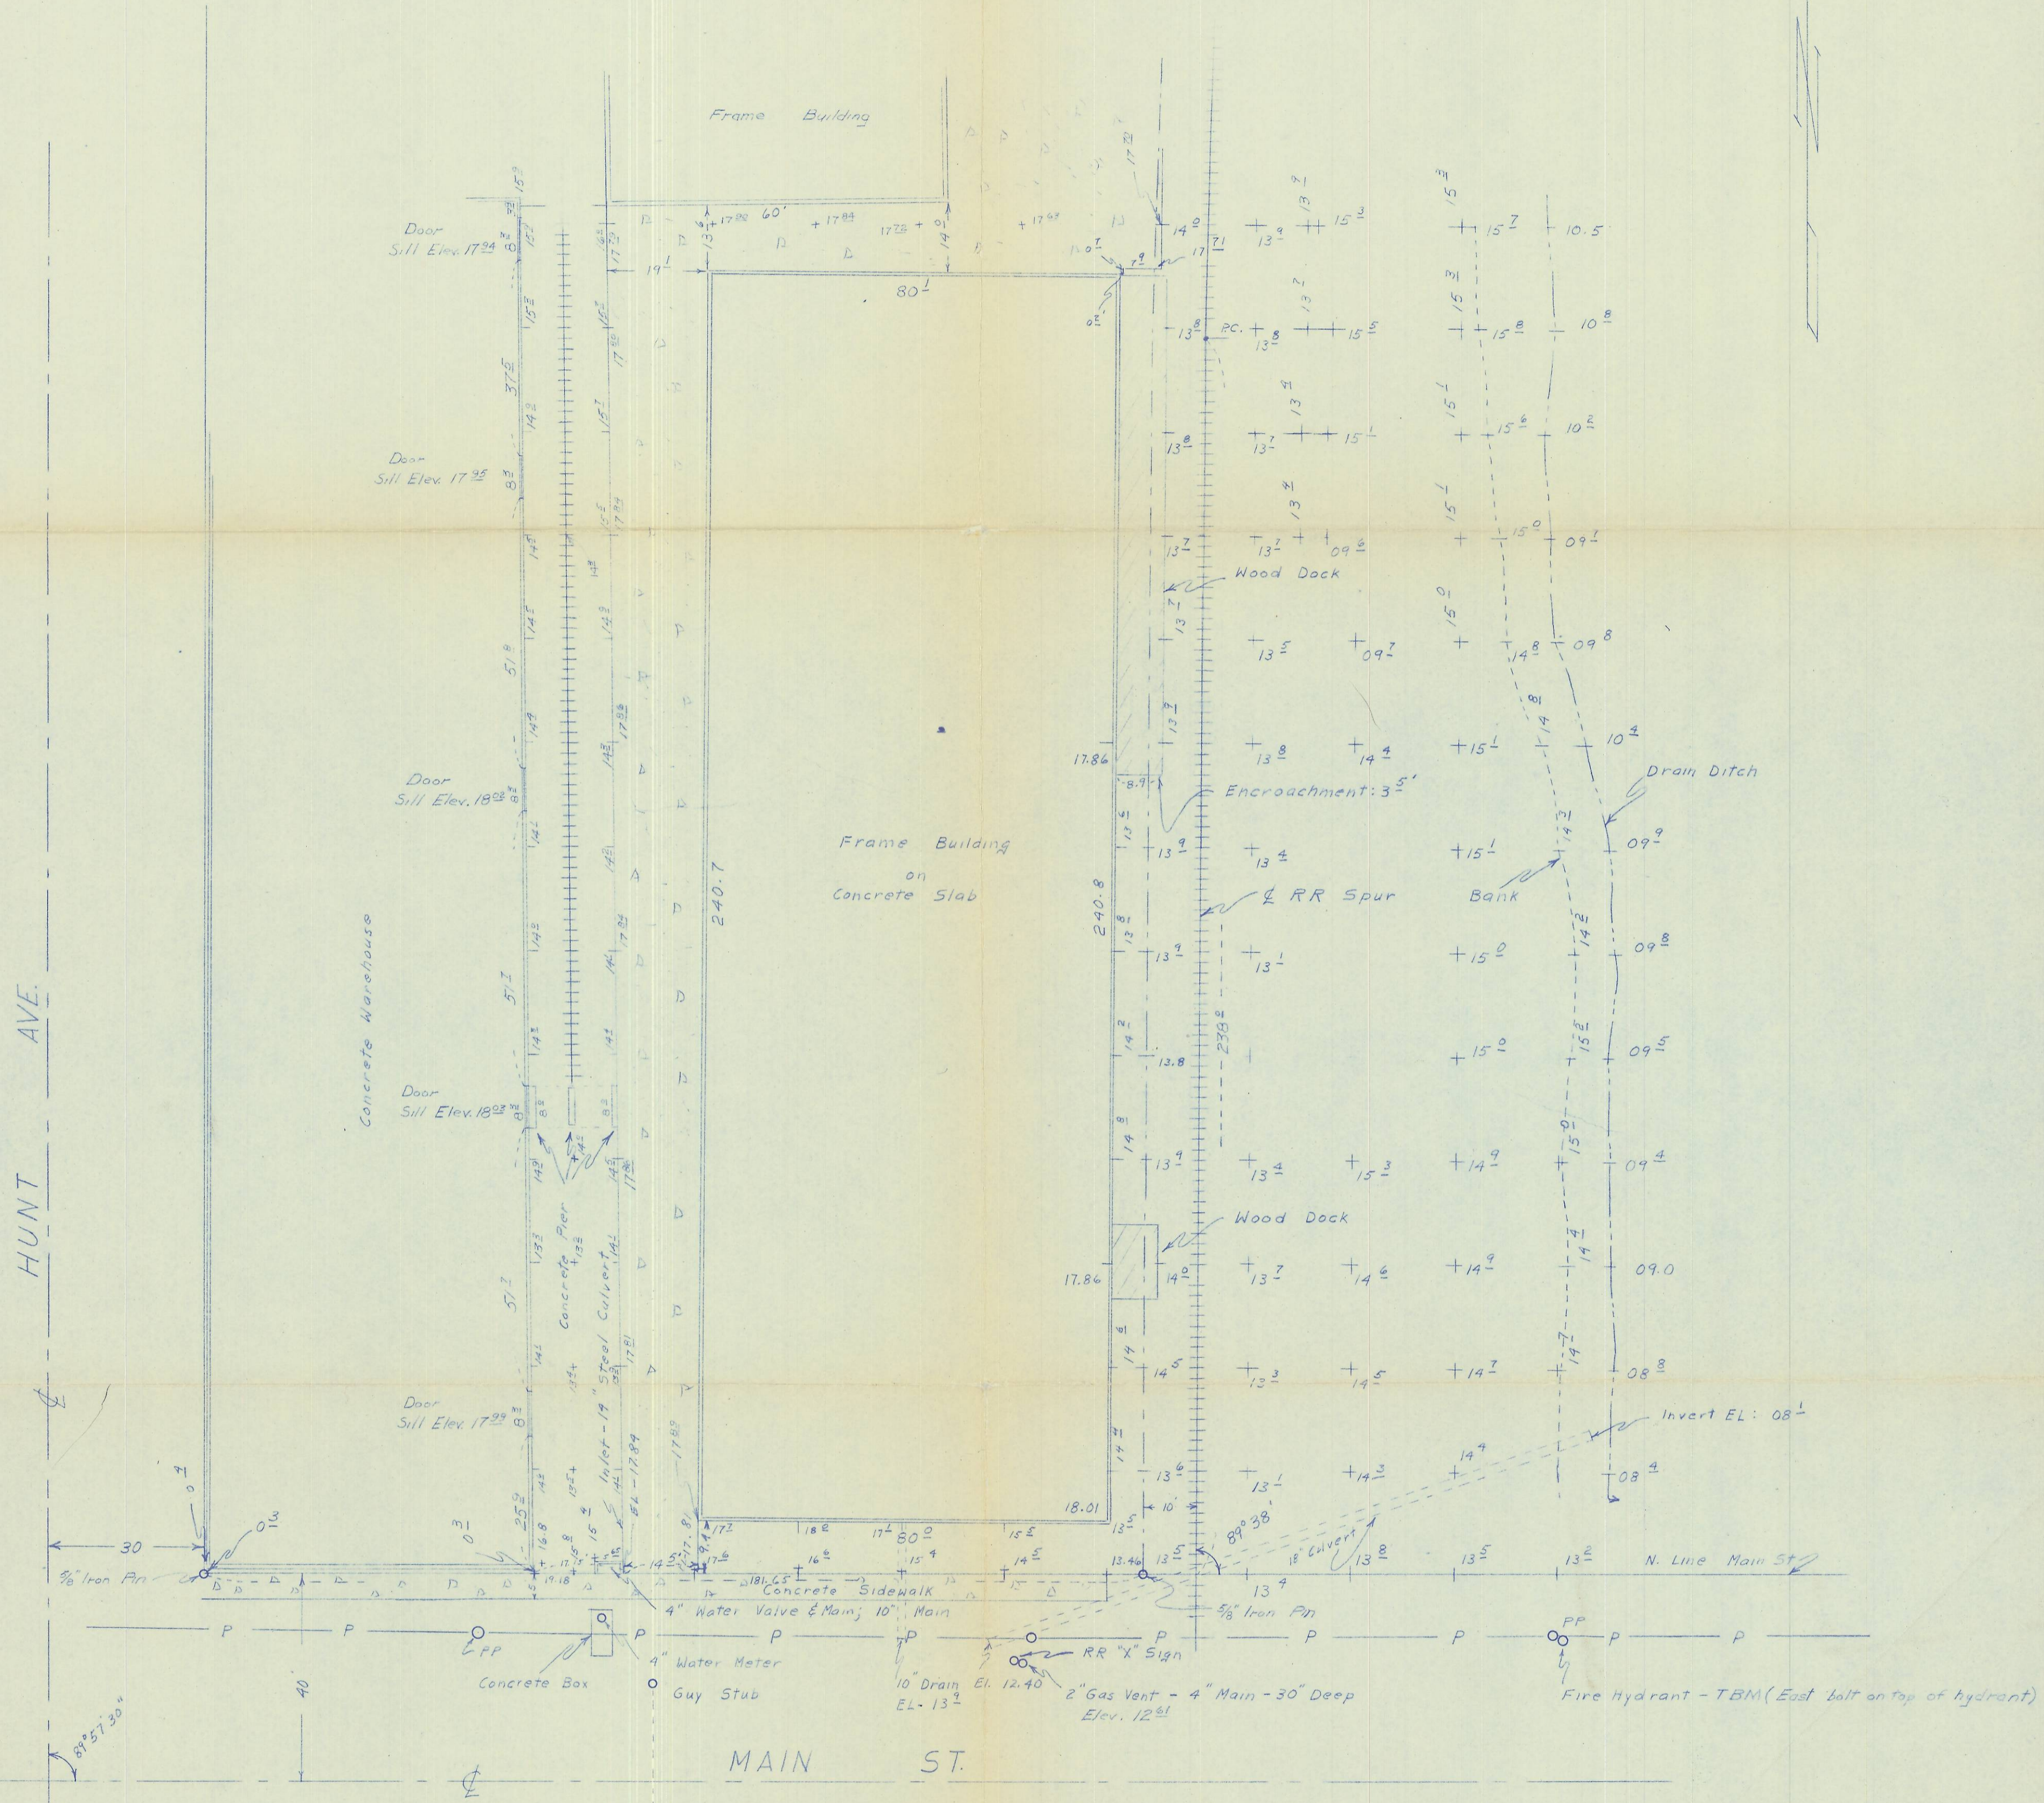

NOTE:
1. Datum is Mean Sea Level; Add 1700'

REGISTERED
OREGON
LAND SURVEYOR
Wayne O. Harris
MAY 6, 1915
WAYNE O. HARRIS
346

HAYES AND HARRIS			
PLOT PLAN			
BOISE CASCADE CORP.			
ROGERS CANNING CO. WAREHOUSE ATHENA, OREGON			
SCALE	DATE	DRN. BY	DRNG. NO.
1" = 20'	8/12/61	W. O. H.	61-117 C

1071-B-4035 P8C