

NATIONAL FOREST LANDS

- Section 28 (all)
- Section 29
The North half
- Section 30
The North half
- Section 33 (all)

HISTORY OF SURVEYS

Township 6 South, Range 33 East was originally subdivided by Frank W. Campbell under GLO contract number 468, dated April 12, 1883.

The Northwest corner and the East 1/4 corner of Section 32 was re-monumented from original GLO corner evidence by Craig L. Wanless in 1977, BLM Group number 350.

BASIS OF BEARING

Solar observation taken at a point 224.00 feet South and 4.93 feet East of the Northeast corner of Section 30, Township 6 South, Range 33 East of the Willamette Meridian. (Hour angle method)

Latitude 45°01'34"
 Longitude 118°46'37"
 Date July 7, 1987
 Time 17:07:18 (GCT)
 Magnetic declination 17° East



SURVEYOR'S STATEMENT

I, Duane I. Griffith, Registered Land Surveyor in the State of Oregon, hereby certify that this plot and the notes hereon, or attached, are a true and correct representation of the survey I made in July, 1987, at the request of the USDA, Forest Service, in accordance with the statutes of the State of Oregon, and with the articles of my contract.

This survey was performed using Zeiss T1-2, one second theodolites. The distances were measured with Mac IE and Mac I1H (infra-red). The purpose of this survey was to locate and establish the National Forest boundary as shown.

I was unable to find the corner to Sections 28, 29, 32 and 33. I therefore ran East searching for section and 1/4 section corners for 2 miles. I find the topography calls in this 2 miles are not distinct enough to use for corner location. Some calls fit, while others do not by a wide margin. At the corner to Sections 26, 27, 34 and 35, I find the marsh as described in the GLO notes. The North-South distance is about a chain short of the call by Mr. Campbell, and the East edge of the marsh is somewhat indistinct. I used the South and West edges of the marsh and set the corner at the call distances from them. By using this method, I find the North-South position fits very well. The distance West to the 1/4 corner common to Sections 29 and 32 is short by 247 feet compared to call distances. However there is no other marsh in the area which will even approximate Mr. Campbell's description. I therefore accept this corner position as the best available evidence.

I find no other unusual conditions on this survey.


Duane I. Griffith
 Duane I. Griffith, OPLS 644
 Baggett, Griffith and Associates
 2006 Adams Avenue
 La Grande, Oregon
 August 3, 1987

LEGEND

- Found standard BLM brass cap monument
- ⊙ Found original GLO corner evidence and set a 2 1/2" x 30" aluminum monument
- ⊙ Set 2 1/2" x 30" aluminum monument at position determined by survey
- SFNF Corner searched for but not found
- () GLO record bearing and distance
- National Forest boundary line posted to standard
- U.S. United States government land administered by the Umatilla National Forest
- P Privately owned land

NOTE:
 For monumentation information, see monumentation sheets filed separately

Scale : 1" = 1000'

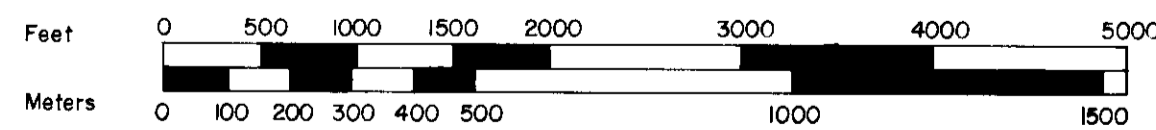

1 Meter = 3.280833333 Feet



BAGETT - GRIFFITH & ASSOCIATES La Grande, Oregon		
Map of Survey		
Location of the National Forest boundary line in Sections 28, 29, 32 and 33, Township 6 South, Range 33 East of the Willamette Meridian.		
UMATILLA COUNTY, OREGON		
SURVEYED FOR	Umatilla National Forest	
SURVEYED BY	d.i.g.	7-87
Scale: 1" = 1000'	Drawn by: R.G.R.	8-87