
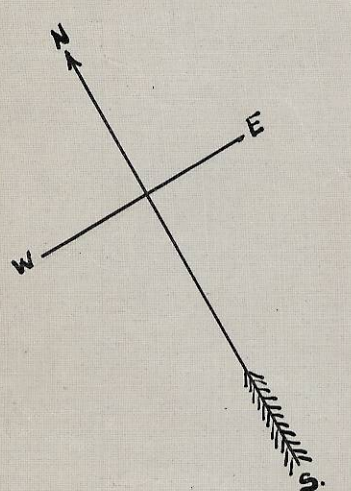


V-11

A-11

V-11

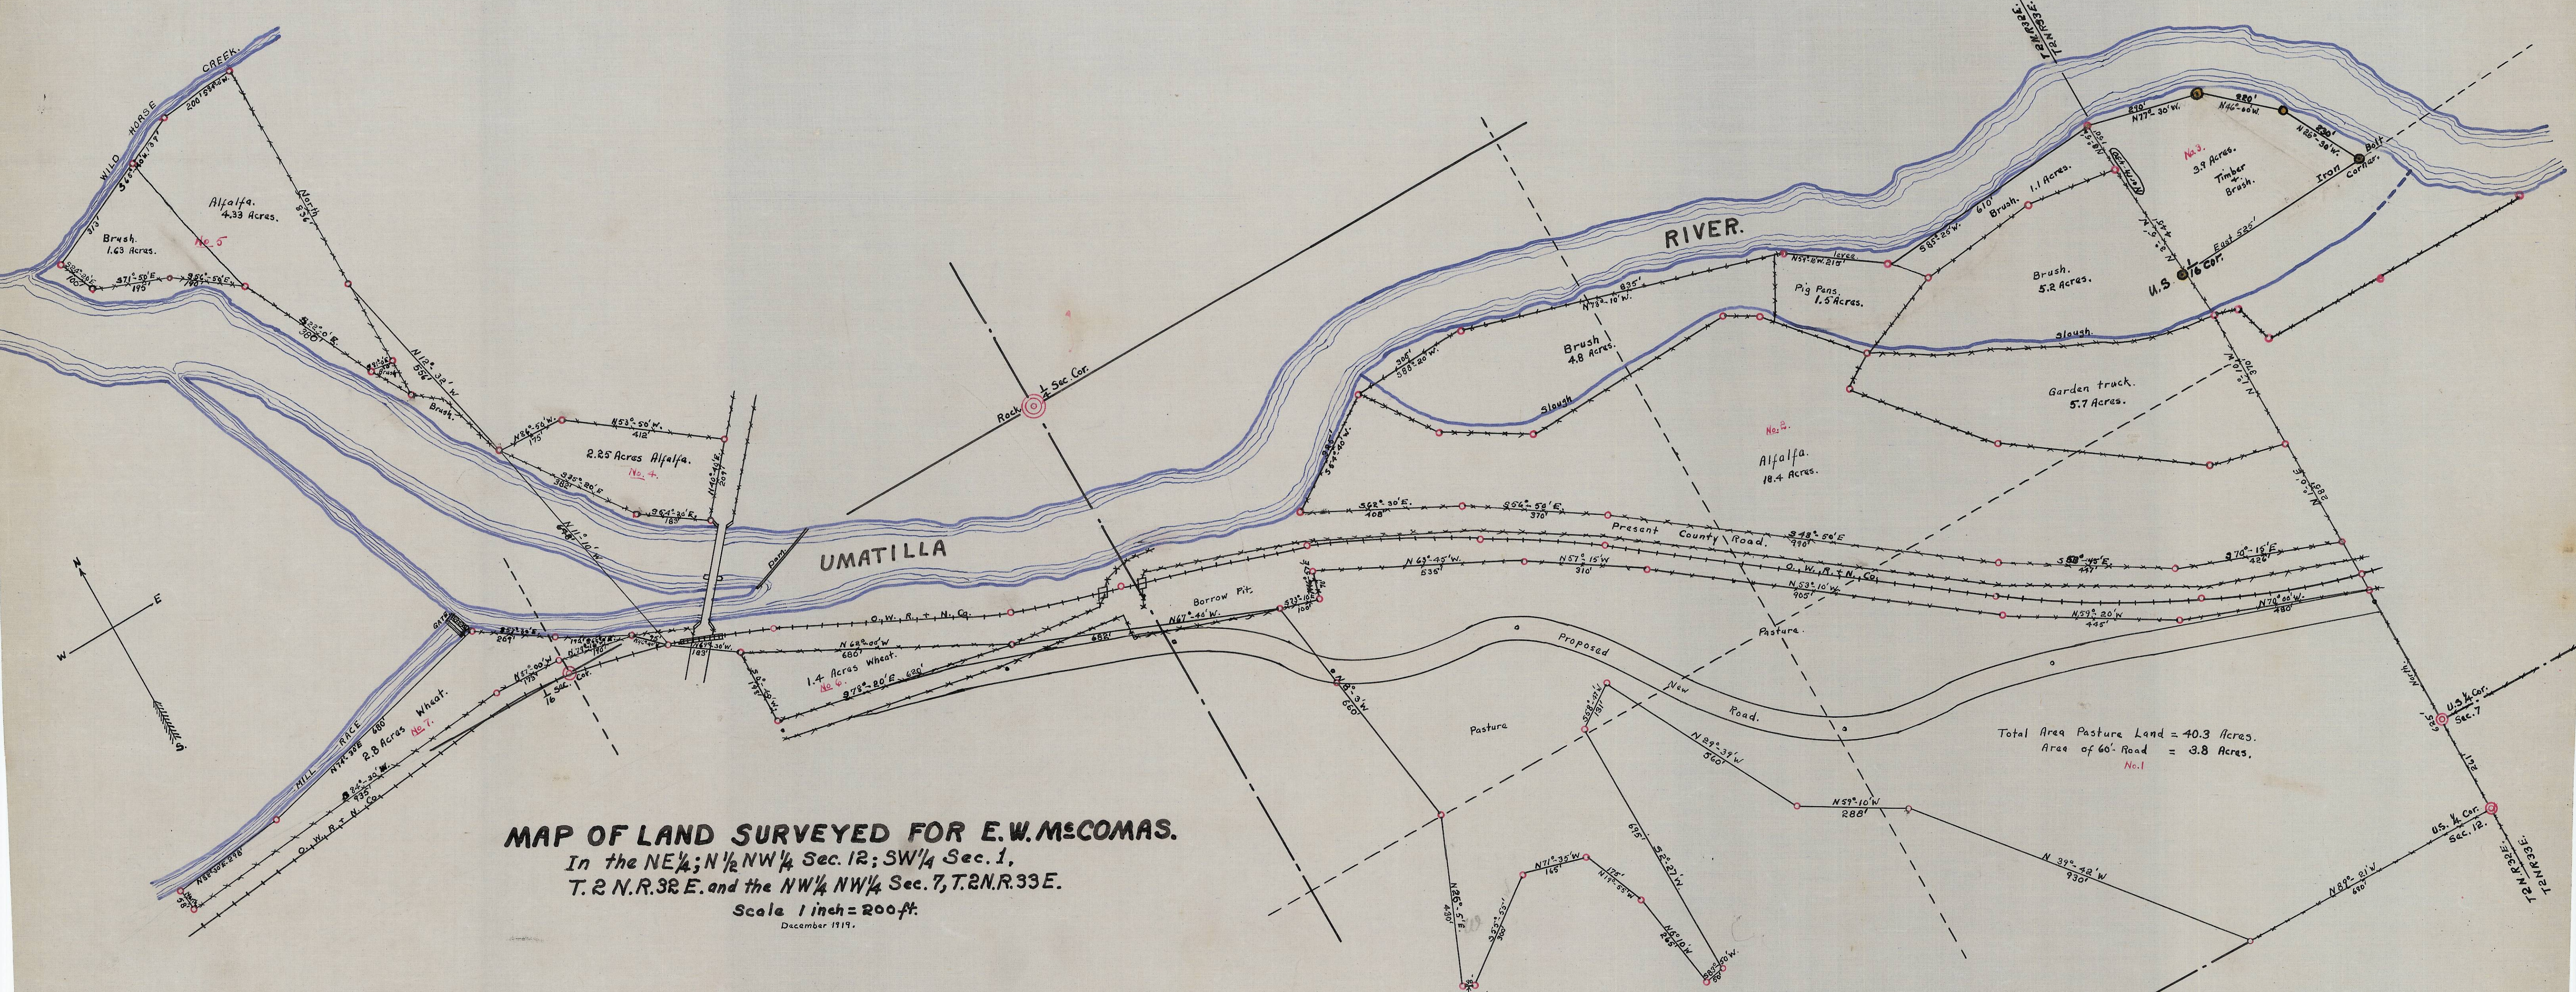

05-93-C

7250