


NARRATIVE:

THE PURPOSE OF THIS SURVEY IS TO STAKE THAT TRACT OF LAND DEEDED TO ROBERT AND LOU ANN BELLINGER ON REEL 130, PAGE 1507, UMATILLA COUNTY DEED RECORDS TO SEE IF THERE ARE ANY ENCROACHMENTS.

I FOUND THAT LEWIS ROAD IS DEDICATED BUT NOT IN USE ALONG THE EAST LINE OF THIS PROPERTY. IT IS IN USE ON THE EAST 20 FEET OF THE 1320 FEET JUST SOUTH OF BRIDGE ROAD.

THIS SURVEY WAS DONE IN REAL TIME KINEMATIC WITH TOPCON HIPER+ C.P.S.. THE SYSTEM WAS LOCALIZED ON MONUMENTS AT THE SW CORNER AND W 1/4 CORNER OF SECTION 18 AND ROTATED TO MATCH MY 1999 SURVEY FOR BREWER.

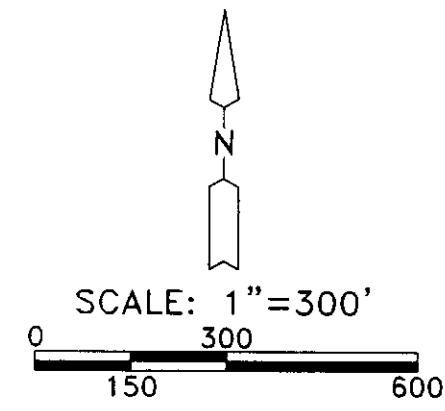

REGISTERED
PROFESSIONAL
LAND SURVEYOR

C. Dennis Edwards

OREGON
JULY 16, 1971
C. DENNIS EDWARDS
9 5 1
RENEWS 12/31/2007

- LEGEND:**
- MONUMENTS FND. AS NOTED
 - SET 5/8"X30" IRON REBAR WITH PLASTIC CAP #951
 - ⊙ COMPUTED LOCATIONS
 - [000] OF RECORD U.S. G.L.O. SURVEYS

SURVEY FOR BELLINGER FARMS
IN E 1/2 SEC. 18, T 4 N, R 28 E,
W.M., UMATILLA COUNTY, OREGON
03/23/2006 JOB# S0603049
EDWARDS SURVEYING P.O. BOX 763
541-567-3336 HERMISTON, OREGON 97838
DRAWN BY JMC

RECEIVED BY
 2-6-66-90
 90-8
 10/16/06
 10/16/06