


NARRATIVE:
 THE PURPOSE OF THIS SURVEY IS TO DO A BOUNDARY LINE ADJUSTMENT TO INCREASE THE SIZE OF TAX LOT 9000 FOR A POSSIBLE SALE.
 TOM LAGIER SURVEYED THIS TRACT IN A 1984 SURVEY FOR THE HERMISTON IRRIGATION DISTRICT AND THE CITY OF HERMISTON. I BASED THIS SURVEY ON THAT 1984 SURVEY.
 I SEARCHED FOR THE SW COR., NW 1/4, NW 1/4, NE 1/4 OF SECTION 9 BUT IT WAS IN VERY THICK TREES AND BRUSH AND MAY NOT HAVE BEEN SET IN 1984. THAT PORTION OF TAX LOT 9000 WHICH LIES WEST OF THE RIVER WOULD BE OF LITTLE USE WITH THE ONLY ACCESS BEING A RIVER FORD.
 THESE TWO TAX LOTS ARE A PORTION OF THE LAND DEEDED TO THE HERMISTON IRRIGATION DISTRICT IN DEEDS BOOK 141, PAGE 349, AND BOOK 167, PAGE 349, UMATILLA COUNTY DEED RECORDS.
 THIS SURVEY WAS CONDUCTED WITH A TOPCON HIPER+ G.P.S.

REGISTERED PROFESSIONAL LAND SURVEYOR
G. Dennis Edwards
 OREGON
 JULY 16, 1971
 G. DENNIS EDWARDS
 9 5 1
 RENEWS 12/31/2011

- LEGEND:**
- FOUND 5/8" I. ROD WITH ALUM. CAP, LAGIER 1984 SURVEY FOR HERMISTON IRRIGATION DIST./CITY OF HERMISTON, UNLESS NOTED OTHERWISE
 - SET 5/8"x30" IRON REBAR WITH PLASTIC CAP #951
 - ⊙ POWER POLES
 - ⊗ COMPUTED LOCATION FROM LAGIER 1984 SUR. FOR HERMISTON IRR. DIST./ CITY OF HERMISTON
 - x-x- FENCE
 - OHP- OVER HEAD POWER
 - EG- EDGE OF GRAVEL ROAD
 - (000) OF RECORD, LAGIER 1984 SURVEY FOR HERMISTON IRRIGATION DIST./CITY OF HERMISTON
 - [000] OF RECORD, TOMKINS 1998 "APPLEWOOD TRACTS"

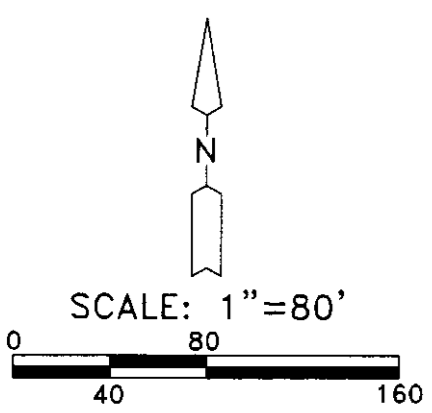

RECEIVED
 Umatilla County Survey Office
 Date 2-10
 Rec'd By KE
 No. 10-09-0

SURVEY FOR HERMISTON IRRIGATION DIST. IN NE 1/4, SEC. 9, T 4 N, R 28 E, W.M., UMATILLA COUNTY, OREGON 11/11/2009 JOB# S0911096 EDWARDS SURVEYING P.O. BOX 763 541-567-3336 HERMISTON, OR 97838 DRAWN BY JMC