

OREGON CORNER RESTORATION FORM

COUNTY: Umatilla. DATE: 03/20/19.

CORNER DESIGNATION: E-19, The North One-Quarter corner of Section 11, Township 1 North, Range 31 East, W.M.

PREVIOUS RENEWALS/SURVEYS ETC: Corner was originally established by Josiah A. Burnett under Contract No. 92 dated September 12, 1860. Notes state: Set a post for 1/4 Sec. Cor., drove charred stake and raised mound with trench as per instructions. John Kimbrell, County Surveyor, in his January 1909 Survey No. 274, reestablished this corner and set a pipe, 4' long at the reestablished corner point.

MONUMENT AND ACCESSORIES FOUND: None. I did not recover Kimbrell's pipe. The corner area has been farmed and is now a CRP field.

MONUMENT MARKING DETAIL:

T1N R31E
S2
1/4 -----
S11
2020
54657 PLS

MONUMENT SET: Reestablished corner position on the parallel of latitude by single proportion measure between the Northeast and Northwest corners of Section 11. At the reestablished corner point, set a 2 1/2" brass cap on 1 1/4 by 30" galvanized iron pipe 28" in the ground. Cap is marked as show in Monument Marking Detail. Set steel fence post 2' North of corner and attached Witness sign.

New accessories:

A silver Deep-1 magnet bears N 43°18' E, 28.2'.

A purple Deep-1 magnet bears S 32°12' E, 27.7'.

A blue Deep-1 magnet bears S 44°42' W, 32.6'.

A orange Deep-1 magnet bears N 58°57' W, 27.6'.

Buried bearing object signs with the Deep-1 magnets, which are buried 18" below ground line.

Bearings to corner accessories are State Plane Grid bearings.

LOCATION AND COMMENTS: Corner is located on a North facing slope in farmed area, now a CRP field.

OREGON STATE PLANE COORDINATE, North Zone NAD 83(91), International Feet Units:


N: 704453.30

E: 8611163.76

FIRM: Wells Surveying
P.O. Box 1696
Pendleton, OR 97801

Surveyor's Seal

\1N31E-19

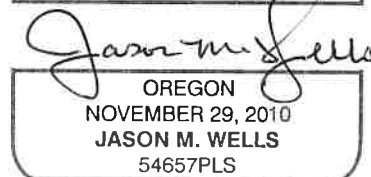

RENEWS: 6/30/20