

OREGON CORNER RESTORATION FORM

COUNTY: Umatilla. DATE: 02/28/20.

CORNER DESIGNATION: L-9 , The East One-Quarter corner of Section 17, Township 1 North, Range 31 East, W.M.

PREVIOUS RENEWALS/SURVEYS ETC: Corner was originally established by Josiah A. Burnett under Contract No. 92 dated September 12, 1860. Notes state: Set a post for 1/4 sec. cor., drove charred stake and raised mound with trench as per instructions. Willard Bradley, County Surveyor, claims to have found a "stake and stone" at this corner in Survey No. 411, found in the old Record of Private Survey Books, (April, 1916).

MONUMENT AND ACCESSORIES FOUND: None. Falls in old CRP field, previously farmed. I reestablish this corner by single proportion measurement between the Northeast and Southeast corners of Section 17.

MONUMENT MARKING DETAIL:

T1N R31E
1/4
S17|S16
2020
54657PLS

MONUMENT SET: At reestablished corner point set a 2 1/2" brass cap on 1 1/4 by 30" galvanized iron pipe 30" in the ground and surrounded with earth mound. Cap is marked as shown in Monument Marking Detail. Set steel fence post 2 1/2' South of corner with Witness sign attached.

New accessories:

- A silver Deep-1 magnet bears N 52°28' E, 29.4'.
- A silver Deep-1 magnet bears S 45°27' E, 36.5'.
- A silver Deep-1 magnet bears S 48°23' W, 31.1'.
- A silver Deep-1 magnet bears N 23°54' W, 32.5'.

Placed bearing object signs with the Deep-1 magnets, below ground. Deep-1 magnets are buried 18" below ground.

Bearings to accessories are State Plane Grid bearings.

LOCATION AND COMMENTS: Corner is located on North slope in old CRP field. There is a North-South fence line on the 1/16 th section line 1/4 mile to the West.


OREGON STATE PLANE COORDINATE, North Zone NAD 83(91), International Feet Units:

N: 696323.67
E: 8598108.43

FIRM: Wells Surveying
P.O. Box 1696
Pendleton, OR 97801

Surveyor's Seal

\1N31L-9

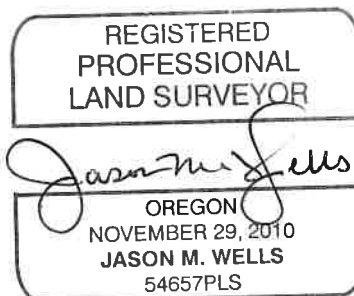

RENEWS: 6/30/20

20-043-C