

**OREGON CORNER RESTORATION FORM**

COUNTY: Umatilla. DATE: 03/06/20

CORNER DESIGNATION: N-5, The Southeast corner of Section 18, Township 1 North, Range 31 East, W.M.

PREVIOUS RENEWALS/SURVEYS ETC: Corner was originally established by Josiah A. Burnett under Contract No. 92 dated September 12, 1860. Notes state: Set a post for corner to Secs. 17, 18, 19 and 20, drove charred stake and raised mound with trench as per instructions.

MONUMENT AND ACCESSORIES FOUND: None. The corner point falls in previously farmed area which is now an active CRP field. Reestablished corner point by double proportion measure holding the Northeast corner of Section 7 and Southeast corner of Section 19 for latitude, and the South One-Quarter corner of Section 17 and the Southwest corner of Section 18 for departure.

MONUMENT MARKING DETAIL:

T1N R31E  
S18|S17  
-----  
S19|S20  
· 2020  
54657PLS

MONUMENT SET: At the reestablished corner point, set a 5/8 by 24" rebar 24" in the ground and surrounded with a 3' diameter rock collar. Set a 2" aluminum cap on the rebar, marked as shown in Monument Marking Detail.

New accessories:

- A silver Deep-1 magnet bears N 20°13' E, 24.0'.
  - A 5/8 by 18" rebar with blue plastic cap marked "Wells Surveying 54657PLS" bears S 57°57' E, 22.0'.
  - A blue Deep-1 magnet bears S 43°15' W, 28.1'.
  - A orange Deep-1 magnet bears N 58°19' W, 22.4'.
- Buried bearing object signs with the Deep-1 magnets. Wired bearing object sign to the rebar accessory. Set steel fence post South of corner monument with Witness sign attached. Bearings to accessories are State Plane Grid bearings.

LOCATION AND COMMENTS: Falls in an active CRP field, West of a ravine. The soil is shallow and stony.


OREGON STATE PLANE COORDINATE, North Zone NAD 83(91), International Feet Units:

N: 693645.06  
E: 8592943.81

FIRM: Wells Surveying  
P.O. Box 1696  
Pendleton, OR 97801

Surveyor's Seal

\1N31N-5

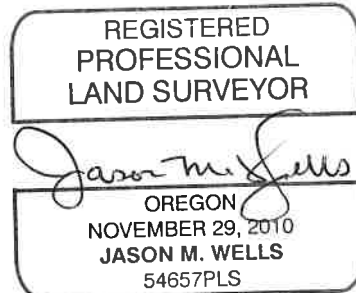

RENEWS: 6/30/20