

OREGON CORNER RESTORATION FORM

Section 33 Township 1N Range 31E
 County Umatilla Date: October 4, 2001

Corner Designation: 1N31Z11



South 1/4 section corner to section 33, T1N, R31E,
 W.M., Umatilla County, Oregon.

Condition Report Only
 Not found
 Remonumented
 Unrecorded
 Surveyed in
 Referenced out

Previous Renewals / Surveys, etc.

The corner was originally set by Josiah Burnett under contract No. 92 dated September 12, 1860. His record reads: Set a post for 1/4 sec. corner. Drove charred stake & raised mound with trench as per instructions.

Monument and Accessories found: (condition and source)
 None. The point falls in a plowed field.

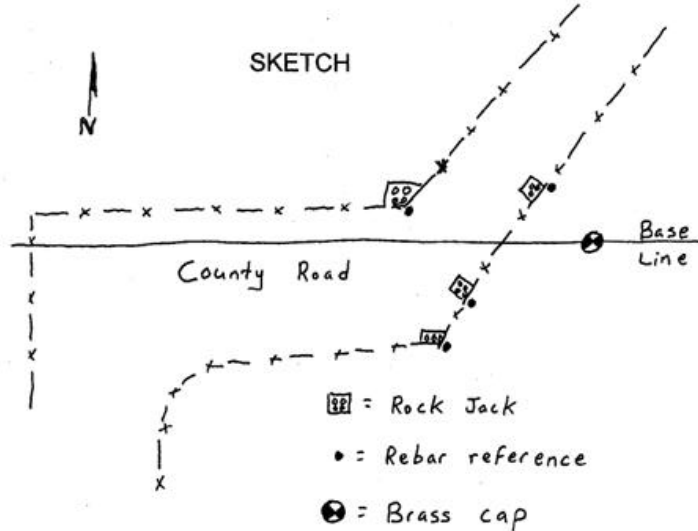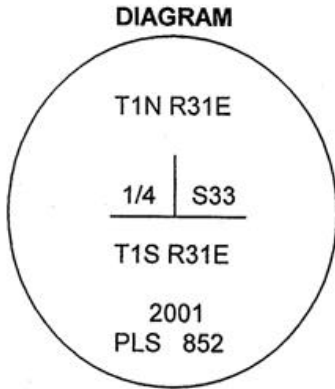

MONUMENT (S) AND ACCESSORIES SET (Procedures and Description)

At the proportionate point I set a 6" x 1 1/2" G.I.P. with a 2 1/2" Brass cap stamped as shown in the diagram above 20" below the surface. The G.I.P. was cemented to a 12" x 5/8" iron rebar that was driven into the bedrock.

For references, I set four 5/8" by 24" rebars with 1 1/4" red plastic caps stamped ORLS 852, and WALS 13922 as described below:

- an iron rebar bears N66°34'36"W, 80.94 feet, near a rock jack west of the County Road;
- an iron rebar bears N80°08'25"W, 130.28 feet, near a rock jack east of the County Road;
- an iron rebar bears S81°58'34"W, 92.10 feet, near a rock jack east of the County Road;
- an iron rebar bears S70°46'15"W, 109.07 feet, near a rock jack east of the County Road;

The monument and references were tied using a LIECA SYSTEM 300 RTK GPS.

Location and comments
 OR SPC Oregon North 1983-91
 N = 677929.58
 E = 8601080.37

Compass Declination

Surveyors Seal

RECEIVED BY:
Umatilla County Surveyor
 Date: 12/20/2001
 Rec'd By: DHK
 No. 01-206-C

Firm / Agency
 Haddock Surveying
 Address
 P.O. Box 1574
 Pendleton, Or. 97801
 Party Chief
 Stephen K, Haddock



David L. Haddock



RENEWS 6-30-03