

CERTIFIED RECORD OF LAND CORNER MONUMENTATION


Corner to Sections 35 and 36, T1N, R31E, W M.

Index: 1N 31 Z-21

History of original corner establishment:

Corner originally set by Burnett under contract 92 dated 1860. His record reads: 80.00 Set post for corner to secs. 35 and 36, drove charred stake and raised mound with trench as per instructions.

DIAGRAM

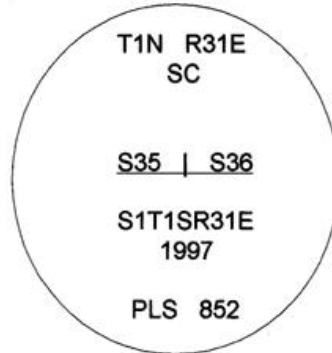

Evidence Found: A fence corner that runs north and east. Corner is 79.901 chains west of the corner for T1N, R31 and 32 E. Record is 80.00 chains. Corner is 9.577 chains east of found stone at northwest corner of Section 1, T1S, R31E. Record - 9.43 chains.

Description of monument and accessories I established to perpetuate the original location of this corner:

At the location of the corner, I set a 1.25" x 30" galvanized iron pipe with 2.25" brass cap, stamped as shown in the diagram, flush with the ground with a collar of stone..

For references, I set four 5/8" by 24" rebars with 1.25" red plastic caps stamped ORLS 852 and WALS 13922 as described below:

- a rebar bears S89°09'E, 35.97 feet;
- a rebar bears N0°32'E, 33.11 feet;
- a rebar bears S00°26'E, 29.68 feet 18" below the surface;
- a rebar bears N89°10'W, 26.14 feet 18" below the surface;

The bearings are true.

This work was done May 14, 1997, and witnessed by Stephen Haddock and Darrel Bigelow.

County of Umatilla
, I hereby certify that the within instrument was filed

Office of _____ by _____
State of _____ (COUNTY OFFICIAL) (DEPUTY)
in this office for record on the _____ day of _____, 19____.



David L. Haddock



RECEIVED BY
Umatilla County Surveyor
Date 7-97
Rec'd By KK
No. 97-140-C