

OREGON CORNER RESTORATION FORM

Section 36 Township 1N Range 31E
 County Umatilla Date: October 2, 2001

Corner Designation: 1N31Z23

South 1/4 section corner to section 36, T1N, R31E,
 W.M., Umatilla County, Oregon.



Condition Report Only
 Not found
 Remonumented
 Unrecorded
 Surveyed in
 Referenced out

Previous Renewals / Surveys, etc.

The corner was originally set by Josiah Burnett under contract No. 92 dated September 12, 1860. His record reads: Set a post for 1/4 sec. corner. Drove charred stake & raised mound with trench as per instructions.

Monument and Accessories found: (condition and source)

A fence corner with fences running north and east. The corner lies within 3 feet of being half way between the senior corners to the east and west.

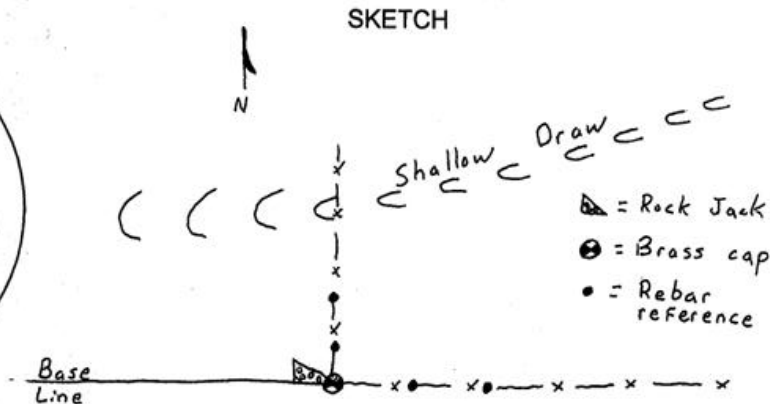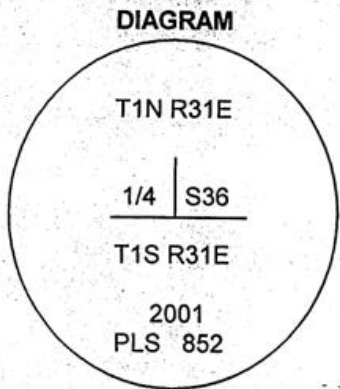

MONUMENT(S) AND ACCESSORIES SET (Procedures and Description)

I determined the northing coordinate for this corner by proportioning the latitude of the senior corners to the east and west and I determined the longitude by holding the longitude of the north - south portion of the fence line. At the corner point I set a 2 1/2" Brass cap on a 30" x 1 1/2" G.I.P. flush with the ground. The point falls on the North side of the existing corner post. The cap was stamped as shown in the diagram above.

For references, I set four 5/8" by 24" rebars with 1 1/4" red plastic caps stamped ORLS 852, and WALS 13922 as described below:

- an iron rebar bears S84°25'34"E, 27.54 feet, under the existing fence;
- an iron rebar bears S87°17'35"E, 56.18 feet, under the existing fence;
- an iron rebar bears N1°21'29"W, 27.19 feet, under the existing fence;
- an iron rebar bears N0°20'09"W, 51.92 feet, under the existing fence;

The monument and references were tied using a LIECA SYSTEM 300 RTK GPS.

Location and comments
 OR SPC Oregon North 1983-91
 N = 678150.61
 E = 8616888.69

Compass Declination

Surveyors Seal

RECEIVED BY:
 Umatilla County Surveyor
 Date: 12/20/2001
 Rec'd By: LDH/K
 No. 01-206-C

Firm / Agency
 Haddock Surveying
 Address
 P.O. Box 1574
 Pendleton, Or. 97801
 Party Chief
 Stephen K, Haddock

**REGISTERED
 PROFESSIONAL
 LAND SURVEYOR**

David L. Haddock

**OREGON
 JULY 12, 1988
 DAVID L. HADDOCK
 852**

RENEWS 6-30-03