

OREGON CORNER RESTORATION FORM

Section 32 Township 1N Range 31E
 County Umatilla Date: October 5, 2001

Corner Designation: 1N31Z5

South section corner to sections 31 and 32, T1N, R31E, W.M., Umatilla County, Oregon.


Condition Report Only
 Not found
 Remonumented
 Unrecorded
 Surveyed in
 Referenced out

Previous Renewals / Surveys, etc.

The corner was originally set by Josiah Burnett under contract No. 92 dated September 12, 1860. His record reads: Set a post for corner to secs. 31 & 32 drove charred stake & raised mound with trench as per instructions. The County Surveyor, Aubrey Perry, in the survey recorded in Book 2 at page 301, records: "Set rock marked I on W. and IIIII on E for Sec. Cor. to Sec. 31-32 on North

Monument and Accessories found: (condition and source)

None. A fence line running north lies 20 feet to the east of this corner and was rejected as evidence by Aubrey Perry in 1919. The current fence location appears to be in the 1919 location based on Mr. Perry's record dimensions.

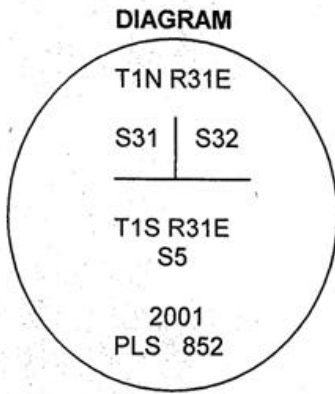


MONUMENT (S) AND ACCESSORIES SET (Procedures and Description)

At the proportionate point I set a 30" x 1 1/2" G.I.P. with a 2 1/2" brass cap stamped as shown in the diagram above flush with the surface. I set a 5' steel guard post with a County monument sign attached along side.

For references, I set four 5/8" by 24" rebars with 1 1/4" red plastic caps stamped ORLS 852, and WAL5 13922 as described below:

- an iron rebar bears N86°52'41"W, 26.41 feet, under the existing fence;
- an iron rebar bears N36°16'34"E, 31.66 feet, under the existing fence;
- an iron rebar bears N85°55'21"E, 19.22 feet, under the existing fence;
- an iron rebar bears N88°48'27"E, 44.37 feet, under the existing fence;

The monument and references were tied using a LIECA SYSTEM 300 RTK GPS.

Location and comments
 OR SPC Oregon North 1983-91
 N = 677836.21
 E = 8593137.22

Compass Declination

Surveyors Seal

RECEIVED BY:
 Umatilla County Surveyor
 Date: 12/20/2001
 Rec'd By: WJK
 No. 01-206-C

Firm / Agency
 Haddock Surveying
 Address
 P.O. Box 1574
 Pendleton, Or. 97801
 Party Chief
 Stephen K, Haddock



David L. Haddock



RENEWS 6-30-03