

OREGON CORNER RESTORATION FORM

Section 1 Township 1N Range 32E
County Umatilla Date: July 1, 2009

Corner Designation: 1N32A21

Corner common to sections 35 and 36, T2N, R32E, and sections 1 and 2, T1N, R32E, W.M., Umatilla County, Oregon.


Condition Report Only
 Not found
 Remonumented
 Unrecorded
 Surveyed in
 Referenced out

Previous Renewals / Surveys, etc.

Corner originally set by David P. Thompson under contract No. 106 dated August 16, 1864. His record reads: Set post for corner to secs. 1, 2, 35 & 36 in mound of earth with charred stake, pits, trench, &c. as per instructions. Zenas Moody, under contract 164, dated October 4, 1871, states: Set post and made earth mound for cor. to secs. 1, 2, 35 and 36. James Currin and James Noland under special instructions dated May 4, 1887 state: Found old mound. Set a basalt stone 12x9x7 ins. for cor. to secs. 1, 2, 35, and 36 marked 1 notch on E. and 5 Notches on W. edges. Mr. Wayne Harris in survey Q-56-Ax states: Set stone with "+" 2' deep. Broken axle over stone. Mr. James Buisman in survey R-79-A states: Set B.C. 6" below existing ground.

Monument and Accessories found: (condition and source)
I found the brass cap set by Buisman as described.

DIAGRAM

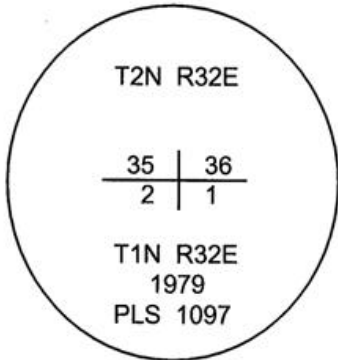

SKETCH

Monument and Accessories set:

None. This certificate is prepared to provide the state plane coordinates only.

The monument was tied using a Trimble R7/R8 RTK GPS System.

Location and comments
NAD 83/1991 State Plane Coordinates
Oregon North Zone.
N = 710,332.65 ift
E = 8,645,871.56 ift

Compass Declination

Surveyors Seal

RECEIVED BY:
Umatilla County Surveyor
Date: 6-10
Rec'd By: SK
No. 10-93-C

Firm / Agency
Witness Tree Surveying
Address
P.O. Box G
Pilot Rock, Or. 97868
Party Chief
Stephen K, Haddock

REGISTERED
PROFESSIONAL
LAND SURVEYOR

Stephen K. Haddock

OREGON
JULY 9, 2001
STEPHEN K. HADDOCK
56295LS

RENEWAL DATE 6-30-11