

OREGON CORNER RESTORATION FORM

Section 1 Township 1N Range 32E
 County Umatilla Date: July 2, 2009

Corner Designation: 1N32A23

Condition Report Only
 Not found
 Remonumented
 Unrecorded
 Surveyed in
 Referenced out

Common quarter corner to section 36, T2N, R32E and section 1, T1N, R32E, W.M., Umatilla County, Oregon.


Previous Renewals / Surveys, etc.

Corner originally set by David P. Thompson under contract #106 dated August 16, 1864. His record reads: Set post for 1/4 sec. corner in mound of earth with charred stake, pits, trench &c. Zenas Moody under contract 164 dated October 4, 1871 states: Set post and made earth mound for 1/4 sec. cor. James Currin and James Noland, under special instructions dated May 4, 1887 state: Set a basalt stone 12x10x10 in the old mound marked 1/4 on N. face. Zenas Moody, in the 1917 Diminished Indian Reservation survey states: Found basalt stone beneath the surface of the roadway. Mr. Bill Wells, in survey 94-109-C set a railroad spike stamped "1106" at the proportioned point and also set a brass capped witness monument marked as shown below.

Monument and Accessories found: (condition and source)

I found the railroad spike and references set by Wells in good condition as described. The witness cap was stamped as shown in the diagram below.

DIAGRAM

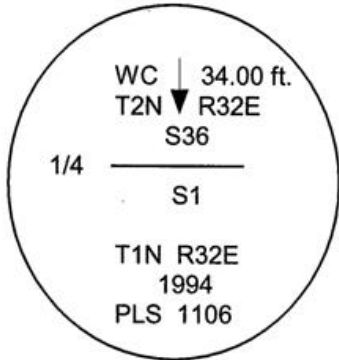

SKETCH

MONUMENT (S) AND ACCESSORIES SET (Procedures and Description)
 None. This certificate is to report the state plane coordinates only.

The monument was tied using a Trimble R7/R8 RTK GPS.

Location and comments
 NAD 83/1991 State Plane Coordinate
 Oregon North Zone.
 N = 710,373.64 ift
 E = 8,648,505.35 ift

Compass Declination

Surveyors Seal

RECEIVED BY:
Umatilla County Surveyor
 Date: 6-10
 Rec'd By: KK
 No. 10-93-C

Firm / Agency
 Witness Tree Surveying
 Address
 P.O. Box G
 Pilot Rock, Or. 97868
 Party Chief
 Stephen K, Haddock

REGISTERED
 PROFESSIONAL
 LAND SURVEYOR

Stephen K. Haddock

OREGON
 JULY 9, 2001
 STEPHEN K. HADDOCK
 56295LS

RENEWAL DATE 6-30-11