

OREGON CORNER RESTORATION FORM

Section 6 Township 1N Range 32E
 County Umatilla Date: December 26, 2009

Corner Designation: 1N32E3

Condition Report Only


- Not found
- Remonumented
- Unrecorded
- Surveyed in
- Referenced out

Quarter corner common to sections 6 and 7, T1N, R32E, W.M., Umatilla County, Oregon.


Previous Renewals / Surveys, etc.

Corner originally set by Daniel Chaplin under contract No. 107 dated September 21, 1864. His record reads: Set post for 1/4 sec. cor. in mound of earth with charred stake, pits &c as per instructions. In the Record of Private Surveys Book 1, Page 471, L.E. Macomber states: Set Old Wagon Skein.

Monument and Accessories found: (condition and source)
 None. The point falls in a farmed field.

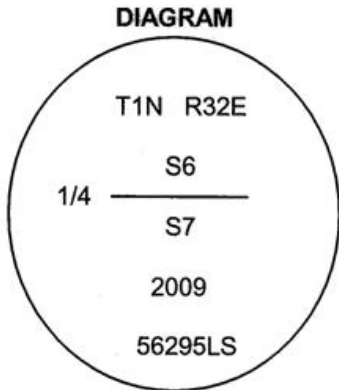

- ⊙ = Brass Cap
- = Rebar Reference

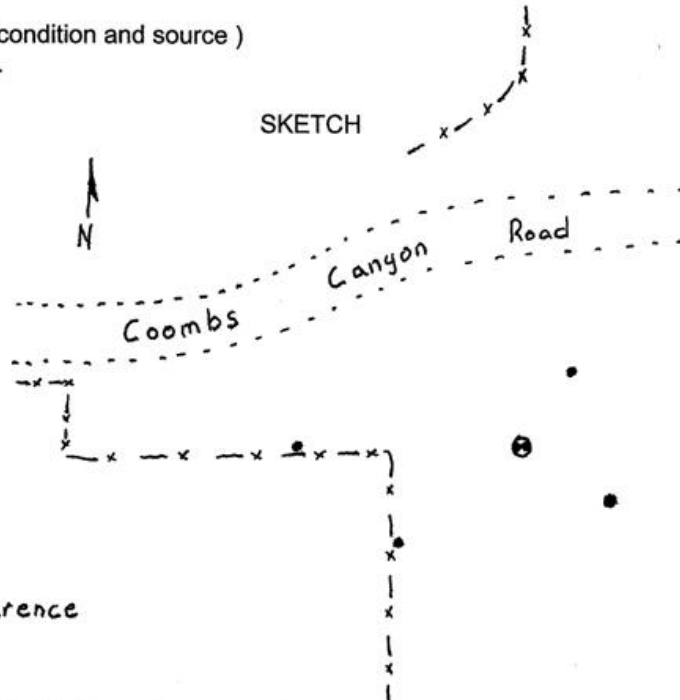

MONUMENT (S) AND ACCESSORIES SET (Procedures and Description)

At the proportioned point I set a 1 1/2" x 30" galvanized iron pipe with a 2 1/2" brass cap stamped as shown in the diagram above. The cap is 22" below the surface of the field.

For references, I set four 5/8" by 24" iron rebars with 1 1/4" orange plastic caps stamped WTS and 56295LS as described below:

- an iron rebar bears N87°43'09"W, 130.44 feet under an existing fence;
- an iron rebar bears S50°53'38"W, 88.35 feet under the existing fence;
- an iron rebar bears N36°51'44"E, 55.61 feet 20" below the surface of the field;
- an iron rebar bears S51°48'50"E, 61.31 feet 20" below the surface of the field;

The monument was set and references were tied using a Trimble R7/R8 RTK GPS system.

Location and comments
 NAD 83/1991 State Plane Coordinate
 Oregon North Zone
 N = 704,612.19 ift
 E = 8,622,260.07 ift

Compass Declination
 Firm / Agency
 Witness Tree Surveying
 Address
 P.O. Box G
 Pilot Rock, Or. 97868
 Party Chief
 Stephen K, Haddock

Surveyors Seal

RECEIVED BY:
Umatilla County Surveyor
 Date: 6-10
 Rec'd By: KK
 No. 10-93-C

REGISTERED
 PROFESSIONAL
 LAND SURVEYOR

Stephen K. Haddock
 OREGON
 JULY 9, 2001
 STEPHEN K. HADDOCK
 56295LS

RENEWAL DATE 6-30-11