

OREGON CORNER RECONSTRUCTION FORM

Section 17 Township 1N Range 32E
 County Umatilla Date: March 11th, 2006

Corner Designation: 1N32J7

Condition Report Only

1/4 corner to sections 8 and 17, T1N, R32E W.M.


Remonumented
 Unrecorded
 Surveyed in
 Referenced out

Previous Renewals / Surveys, etc.

Corner originally set by Daniel Chaplin under contract No. 107 Dated September 21, 1864.
 His record reads: Set stone 18 x 8 x 8 for 1/4 sec. cor.

Monument and Accessories found: (condition and source)

None. This area has been disturbed by the dumping of scrap iron from farming. There is a North - South fence that approximately half of it is buried by blowing dirt.

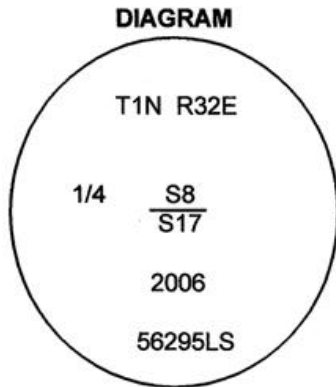

MONUMENT (S) AND ACCESSORIES SET (Procedures and Description)

I set a 1 1/4" x 30" Galvanized Iron Pipe with a 2 1/2" brass cap flush with the surface at the intersection of the North - South fence and the Section line. The cap was stamped as shown in the diagram above.

For references I set four 5/8" x 24" iron rebars with 1.25" orange plastic caps stamped WTS and 56295LS as described below:

- an iron rebar bears N01°44'19"E, 71.28 feet under the existing fence;
- an iron rebar bears N67°48'47"E, 71.92 feet at the top of the north bank of the gully;
- an iron rebar bears N83°42'13"W, 91.80 feet on the north bank of the gully;
- an iron rebar bears S03°46'05"W, 4.67 feet under the existing fence corner;

The monument was set and references tied using a Trimble R7/R8 RTK GPS.

Location and comments

Compass Declination

Surveyors Seal

RECEIVED BY:
Umatilla County Surveyor
 Date: 5-06
 Rec'd By: [Signature]
 No. 06-140-B

Firm / Agency
 Witness Tree Surveying
 Address
 P.O. Box G
 Pilot Rock, OR 97868
 Party Chief
 Stephen K, Haddock

REGISTERED
 PROFESSIONAL
 LAND SURVEYOR

Stephen K. Haddock

OREGON
 JULY 9, 2001
 STEPHEN K. HADDOCK
 56295LS

RENEWAL DATE 6-30-07