

OREGON CORNER RESTORATION FORM

Section 17 Township 1N Range 32E
County Umatilla Date: July 29, 2009

Corner Designation: 1N32J7 Condition Report Only
Not found
Remonumented
Unrecorded
Surveyed in
Referenced out

Quarter corner common to sections 8 and 17,
T1N, R32E, W.M., Umatilla County, Oregon.


Previous Renewals / Surveys, etc.

Corner originally set by Daniel Chaplin under contract No. 107 Dated September 21, 1864.
His record reads: Set stone 18 x 8 x 8 for 1/4 sec. cor. Stephen K. Haddock under survey
06-140-B states: Set brass cap and four reference monuments.

Monument and Accessories found: (condition and source)
I found the brass cap from my prior survey in good condition.

DIAGRAM

SKETCH

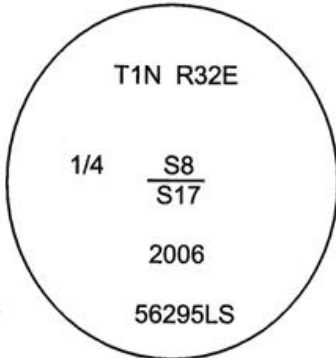

MONUMENT (S) AND ACCESSORIES SET (Procedures and Description)

None. I held my previous monument. This certificate is being filed to report the state plane coordinates for the corner listed below.

For references:

The monument was tied using a Trimble R7/R8 RTK GPS system.

Location and comments
NAD 83/1991 State Plane Coordinate
Oregon North Zone
N = 699,474.28 ift
E = 8,627,547.95 ift

Compass Declination

Surveyors Seal

RECEIVED BY:
Umatilla County Surveyor
Date: 6-10
Rec'd By: KK
No. 10-95-C

Firm / Agency
Witness Tree Surveying
Address
P.O. Box G
Pilot Rock, OR 97868
Party Chief
Stephen K, Haddock

REGISTERED
PROFESSIONAL
LAND SURVEYOR

Stephen K. Haddock

OREGON
JULY 9, 2001
STEPHEN K. HADDOCK
56295LS

RENEWAL DATE 6-30-11