

OREGON CORNER RESTORATION FORM

Section 13 Township 1N Range 32E
 County Umatilla Date: July 7, 2009

Corner Designation: 1N32N23

Condition Report Only

- Not found
- Remonumented
- Unrecorded
- Surveyed in
- Referenced out


Quarter corner common to sections 13 and 24,
 T1N, R32E, W.M., Umatilla County, Oregon.

Previous Renewals / Surveys, etc.


Corner originally set by Daniel Chaplin under contract No. 107 dated September 21, 1864.
 His record reads: Set post for 1/4 sec. corner in mound of earth with charred stake, pits &c as per instructions. Zenas F. Moody under contract No. 164, dated October 4, 1871, stated: Set post. Currin and Noland under special contract dated May 4, 1887, stated: Set stone 6 x 7 x 10 ins. Mr. Wayne Harris set a 5/8" iron rebar in a 1970's unrecorded survey for Dan Shaw.

Monument and Accessories found: (condition and source)

I found the 5/8" iron rebar set by Harris on the north side of a fence corner with fences running south and east.

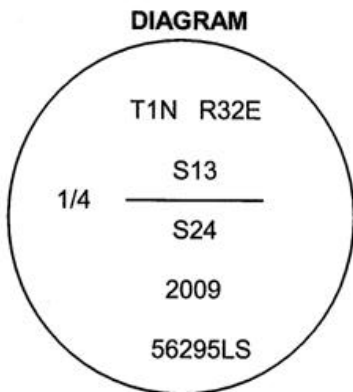

- ⊙ = Brass Cap
- = Steel Guard Post
- = Rebar Reference

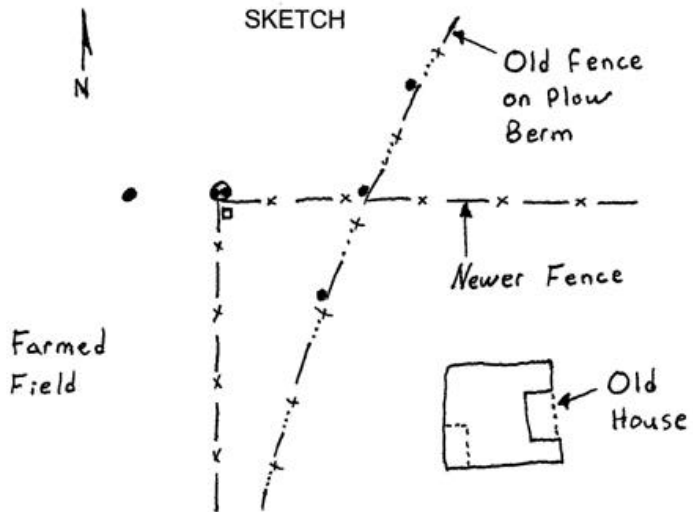

MONUMENT (S) AND ACCESSORIES SET (Procedures and Description)

I set a 1 1/2" x 30" galvanized iron pipe with a 2 1/2" brass cap over the rebar set by Harris. The Harris pin is inside the new monument. The brass cap is stamped as shown above.

For references, I set four 5/8" by 24" iron rebars with 1 1/4" orange plastic caps stamped WTS and 56295LS as described below:

- an iron rebar bears N87°12'30"W, 33.03 feet, 2 feet below the surface of the field;
- an iron rebar bears S16°19'29"E, 63.80 feet in an old fence and plow berm;
- an iron rebar bears N86°54'50"E, 32.74 feet in an old fence and plow berm;
- an iron rebar bears N35°34'28"E, 78.66 feet in an old fence and plow berm;

The monument and references were tied using a Trimble R7/R8 RTK GPS system.

Location and comments
 NAD 83/1991 State Plane Coordinate
 Oregon North Zone
 N = 694,562.71 ift
 E = 8,648,774.44 ift

Compass Declination

Surveyors Seal

RECEIVED BY:
 Umatilla County Surveyor
 Date: 6-10
 Rec'd By: SK
 No. 10-93-C

Firm / Agency
 Witness Tree Surveying
 Address
 P.O. Box G
 Pilot Rock, Or. 97868
 Party Chief
 Stephen K, Haddock

REGISTERED
 PROFESSIONAL
 LAND SURVEYOR

Stephen K. Haddock

OREGON
 JULY 9, 2001
 STEPHEN K. HADDOCK
 56295LS

RENEWAL DATE 6-30-11