

**OREGON CORNER RESTORATION FORM**



Section 24 Township 1N Range 32E  
 County Umatilla Date: July 6, 2009

Corner Designation: 1N32P25 Condition Report Only  
 Not found  
 East quarter corner of section 24 only, T1N, R32E, W.M., Umatilla County, Oregon x Remonumented  
x Unrecorded  
x Surveyed in  
x Referenced out

Previous Renewals / Surveys, etc.

Corner originally set by David P. Thompson under contract No. 106 Dated August 16, 1864. His record reads: Set stone 15x12x10 ins. for 1/4 sec. corner. Zenas Moody, under contract No. 164 dated September 21, 1871 states: Set stone, 14x12x9. James Currin and James Noland under special contract dated May 4, 1887 state: Found pits and mound. Set a basalt stone, 14x12x8 ins. marked 1/4 on west face and raised earth mound. Lincoln Wilkes in his 1917 resurvey states: set an iron post 3 ft. long, 2 ins. diam. with brass cap.

Monument and Accessories found: ( condition and source )  
 None. The point falls in a plowed field.

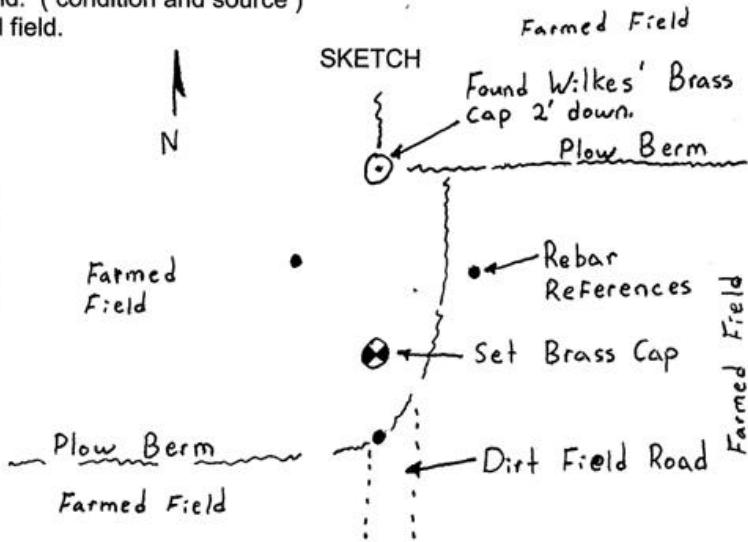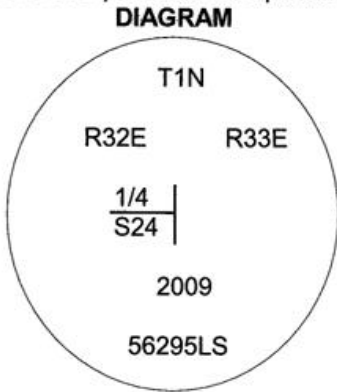

**MONUMENT (S) AND ACCESSORIES SET (Procedures and Description)**

At the proportionate point I set a 1 1/2" x 30" galvanized iron pipe with a 2 1/2" brass cap stamped as shown in the diagram above. The cap is 24" below the surface.

For references I set three 5/8"x24" iron rebars with 1 1/4" orange plastic caps stamped WTS and 56295LS as follows:

an iron rebar bears S01°18'25"E 105.35 feet, 2 feet below the surface.

an iron rebar bears N47°09'32"E 87.04 feet, 2 feet below the surface.

an iron rebar bears N39°00'36"W 84.64 feet, 2 feet below the surface.

The Lincoln Wilkes brass cap for the closing 1/4 corner to Section 19, T1N, R33E, bears N00°03'17"W 116.15 feet, 18" below the surface;

The monument was set and references were tied using a Trimble R7/R8 RTK GPS system.

Location and comments  
 NAD 83/1991 State Plane Coordinate  
 Oregon North Zone  
 N=691,958.01 ift  
 E=8,651,449.24 ift

Compass Declination

Surveyors Seal

RECEIVED BY:  
Umatilla County Surveyor  
 Date: 6-10  
 Rec'd By: KK  
 No. 10-93-C

Witness Tree Surveying  
 Address  
 P.O. Box G  
 Pilot Rock, Or. 97868  
 Party Chief  
 Stephen K, Haddock

REGISTERED  
 PROFESSIONAL  
 LAND SURVEYOR

*Stephen K. Haddock*

OREGON  
 JULY 9, 2001  
 STEPHEN K. HADDOCK  
 56295LS

RENEWAL DATE 6-30-11