



OREGON CORNER RESTORATION FORM

Section 17 Township 1N Range 32E
 County Umatilla Date: March 9th, 2006

Corner Designation: 1N32N5 Condition Report Only
 Not found
 Corner to sections 17, 18, 19 and 20, T1N, R32E W.M. x Remonumented
 Unrecorded
 Surveyed in
x Referenced out

Previous Renewals / Surveys, etc.
 Corner originally set by Daniel Chaplin under contract No. 107 dated September 21, 1864.
 His record reads: Set stone 18 x 12 x 8 for corner to sections 17, 18, 19, & 20.

Monument and Accessories found: (condition and source)
 None. The point falls in the center of the county road.

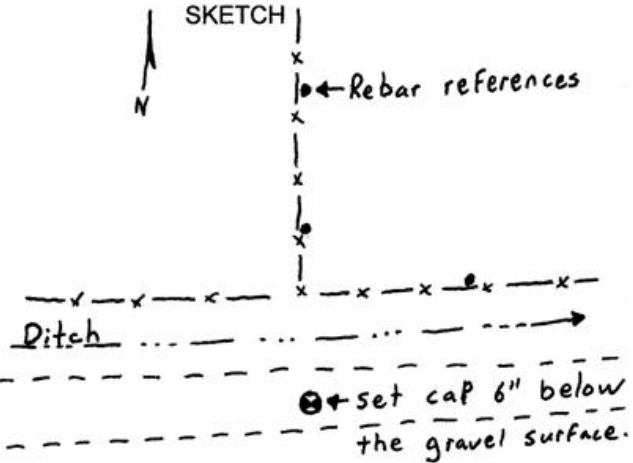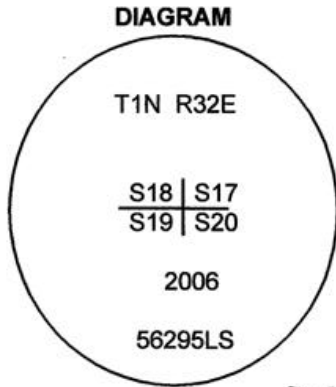

Marker paddle for →
 Mile Post 1.

MONUMENT (S) AND ACCESSORIES SET (Procedures and Description)

I set a 1 1/4" x 30" Galvanized Iron Pipe with a 2 1/2" brass cap stamped as shown in the diagram above at the intersection of the fence line to the north and the County Road centerline. For references I set four 5/8" x 24" iron rebars with 1.25" orange plastic caps stamped WTS and 56295LS as described below:
 an iron rebar bears S88°56'04"W, 418.98 feet 20 inches east of the mile marker post for Mile 1;
 an iron rebar bears N04°34'23"W, 63.34 feet under the existing fence;
 an iron rebar bears N00°47'52"W, 188.99 feet in a small mound of stone;
 an iron rebar bears N61°22'32"E, 71.74 feet;

The monument and references were tied using a Trimble R7/R8 RTK GPS

Location and comments

Compass Declination

Surveyors Seal

RECEIVED BY:
Umatilla County Surveyor
 Date: 5-06
 Rec'd By: QS
 No. 06-140-13

Firm / Agency
 Witness Tree Surveying
 Address
 P.O. Box G
 Pilot Rock, OR 97868
 Party Chief
 Stephen K, Haddock

REGISTERED
 PROFESSIONAL
 LAND SURVEYOR

Stephen K. Haddock

OREGON
 JULY 9, 2001
 STEPHEN K. HADDOCK
 56295LS

RENEWAL DATE 6-30-07