

**OREGON CORNER RESTORATION FORM**

Section 17 Township 1N Range 32E  
County Umatilla Date: July 2, 2009

Corner Designation: 1N32N5  Condition Report Only  
Not found  
Remonumented  
Unrecorded  
Surveyed in  
Referenced out

Corner common to sections 17, 18, 19 and 20,  
T1N, R32E, W.M., Umatilla County, Oregon.


Previous Renewals / Surveys, etc.

Corner originally set by Daniel Chaplin under contract No. 107 dated September 21, 1864.  
His record reads: Set stone 18 x 12 x 8 for corner to sections 17, 18, 19, & 20. Stephen K.  
Haddock under survey 06-140-B states: Set brass cap and four reference monuments.

Monument and Accessories found: ( condition and source )  
The brass cap I set under survey 06-140-B is in good condition.

**DIAGRAM**

**SKETCH**

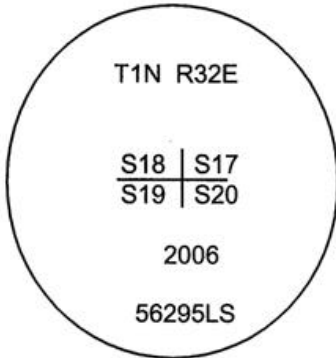

MONUMENT (S) AND ACCESSORIES SET (Procedures and Description)  
None. I held the monument from my previous survey. This certificate is being filed to report  
the state plane coordinates shown below.

For references:

The monument was tied using a Trimble R7/R8 RTK GPS

Location and comments                      Compass Declination  
NAD 83/1991 State Plane Coordinate  
Oregon North Zone  
N = 694,116.66 ift  
E = 8,625,026.78 ift

RECEIVED BY:  
Umatilla County Surveyor  
Date: 6-10  
Rec'd By: SK  
No. 10-93-C

Firm / Agency  
Witness Tree Surveying  
Address  
P.O. Box G  
Pilot Rock, OR 97868  
Party Chief  
Stephen K, Haddock

Surveyors Seal

REGISTERED  
PROFESSIONAL  
LAND SURVEYOR

*Stephen K. Haddock*

OREGON  
JULY 9, 2001  
STEPHEN K. HADDOCK  
56295LS

RENEWAL DATE 6-30-11