

OREGON CORNER RESTORATION FORM

Section 17 Township 1N Range 32E
 County Umatilla Date: March 9th, 2006

Corner Designation: 1N32N7

Quarter corner common to sections 17 and 20, T1N, R32E,
 W.M., Umatilla County, Oregon.

Condition Report Only
 Not found
 Remonumented
 Unrecorded
 Surveyed in
 Referenced out


Previous Renewals / Surveys, etc.

Corner originally set by Daniel Chaplin under contract No. 107 dated Sept 21, 1864.

His record reads: Set post for 1/4 Sec. Cor., in mound of earth, with charred stake, pits, etc., as per instructions.

Monument and Accessories found: (condition and source)

None. The corner falls in the intersection of three county roads.

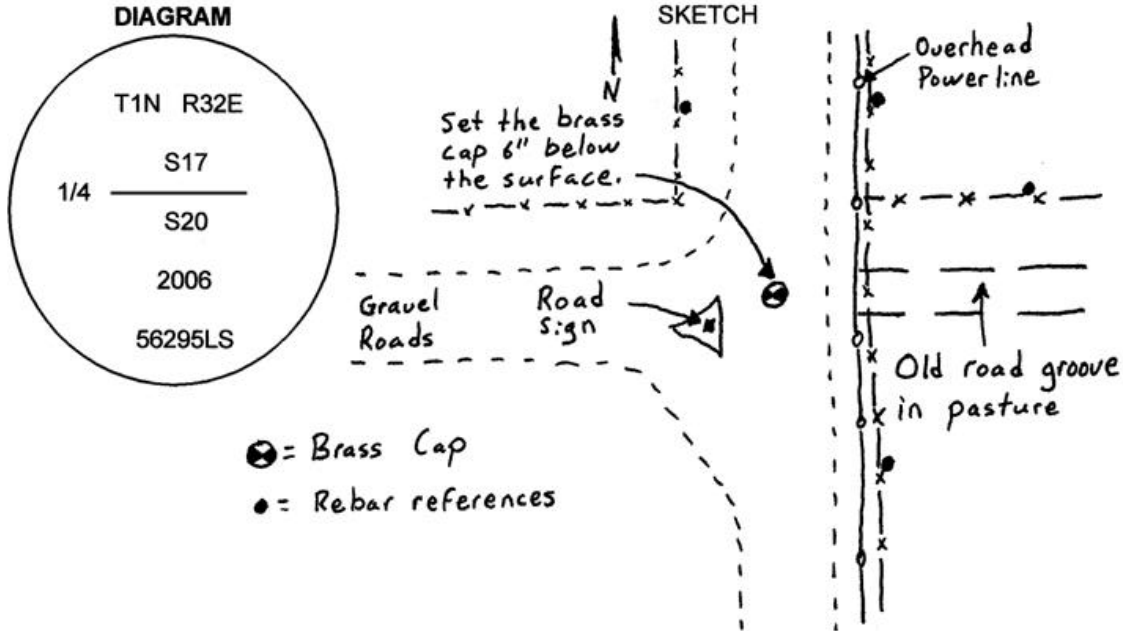

MONUMENT (S) AND ACCESSORIES SET (Procedures and Description)

I set a 1 1/2" x 30" galvanized iron pipe with a 2 1/4" brass cap attached stamped as shown in the diagram above. The cap is 6 inches below the surface of a gravel road.

For references, I set four 5/8" by 24" rebars with 1.25" orange plastic caps stamped WTS and 56295LS as described below:

- an iron rebar bears N34°51'22"W, 52.70 feet under the west right of way fence;
- an iron rebar bears N15°23'21"E, 111.84 feet under the east right of way fence;
- an iron rebar bears N77°27'10"E, 72.82 feet under the existing fence;
- an iron rebar bears S38°27'21"E, 51.53 feet under the east right of way fence;

The monument and references were tied using a Trimble R7/R8 RTK GPS.

Location and comments

RECEIVED BY:
Umatilla County Surveyor
 Date: 5-06
 Rec'd By: YS
 No. 06-140-B

Compass Declination
 Firm / Agency
 Witness Tree Surveying
 Address
 P.O. Box G
 Pilot Rock, OR 97868
 Party Chief
 Stephen K, Haddock

Surveyors Seal

