

OREGON CORNER RESTORATION FORM

Section 17 Township 1N Range 32E
County Umatilla Date: July 2, 2009

Corner Designation: 1N32N7

Condition Report Only
 Not found
 Remonumented
 Unrecorded
 Surveyed in
 Referenced out

Quarter corner common to sections 17 and 20,
T1N, R32E, W.M., Umatilla County, Oregon.


Previous Renewals / Surveys, etc.

Corner originally set by Daniel Chaplin under contract No. 107 dated Sept 21, 1864.
His record reads: Set post for 1/4 Sec. Cor., in mound of earth, with charred stake, pits, etc., as
per instructions. Stephen K. Haddock under survey 06-140-B states: Set brass cap and four
reference monuments.

Monument and Accessories found: (condition and source)
The brass cap I set under survey 06-140-B is in good condition.

DIAGRAM

SKETCH

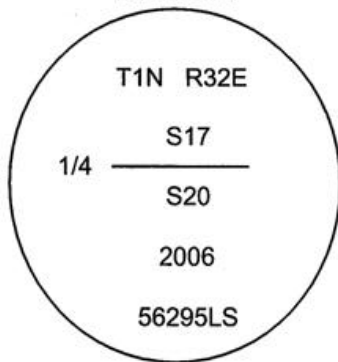

MONUMENT (S) AND ACCESSORIES SET (Procedures and Description)
None. I held the monument from my survey 06-140-B. This certificate is being filed to report
the state plane coordinates shown below.

For references:

The monument was tied using a Trimble R7/R8 RTK GPS.

Location and comments
NAD 83/1991 State Plane Coordinate
Oregon North Zone
N = 694,135.65 ift
E = 8,627,666.08 ift

Compass Declination
Firm / Agency
Witness Tree Surveying
Address
P.O. Box G
Pilot Rock, OR 97868
Party Chief
Stephen K, Haddock

Surveyors Seal

RECEIVED BY:
Umatilla County Surveyor
Date: 6-10
Rec'd By: KK
No. 10-93-C

REGISTERED
PROFESSIONAL
LAND SURVEYOR

Stephen K. Haddock

OREGON
JULY 9, 2001
STEPHEN K. HADDOCK
56295LS

RENEWAL DATE 6-30-11