

**OREGON CORNER RESTORATION FORM**



Section 21 Township 1N Range 32E  
 County Umatilla Date: December 19, 2009

Corner Designation: 1N32P13 Condition Report Only  
 Not found  
 Remonumented  
 Unrecorded  
 Surveyed in  
 Referenced out

Quarter corner common to sections 21 and 22,  
 T1N, R32E, W.M., Umatilla County, Oregon.

Previous Renewals / Surveys, etc.  
 Corner originally set by Daniel Chaplin under contract No. 107 Dated September 21, 1864.  
 His record reads: Set post for 1/4 section corner in mound of earth with charred stake,  
 pits, etc., as per instructions. In Partition Plat 2009-19, Bill Wells calculated a position by single  
 proportion but did not monument it.

Monument and Accessories found: ( condition and source )  
 None. This point falls in a plowed field.

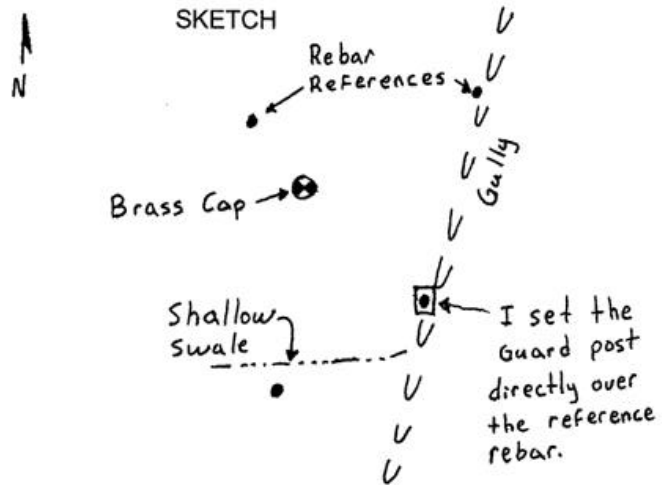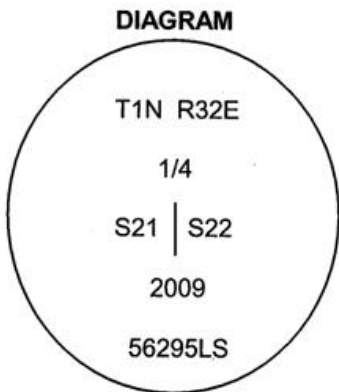

**MONUMENT (S) AND ACCESSORIES SET (Procedures and Description)**

I set a 1 1/2" x 30" galvanized iron pipe with a 2 1/2" brass cap stamped as shown in the diagram above at the position established by Wells. the cap is 24" below the surface of the field.

For references, I set four 5/8" by 24" iron rebars with 1 1/4" orange plastic caps stamped WTS and 56295LS as described below:

- an iron rebar bears N30°07'07"W, 62.69 feet 2 feet below the surface of the field;
- an iron rebar bears N74°42'25"E, 146.19 feet 2 feet below the surface;
- an iron rebar bears S23°41'17"E 160.52 feet 2 feet below the surface. A steel guard post with a monument sign is set directly over the top of the pin.
- an iron rebar bears S35°22'17"W, 202.82 feet 2 feet below the surface;

The monument was set and references tied using a Trimble R7/R8 RTK GPS system.

Location and comments  
 NAD 83/1991 State Plane Coordinate  
 Oregon North Zone  
 N = 691,696.47 ift  
 E = 8,635,614.48 ift

Compass Declination  
 Firm / Agency  
 Witness Tree Surveying  
 Address  
 P.O. Box G  
 Pilot Rock, OR 97868  
 Party Chief  
 Stephen K, Haddock

Surveyors Seal

RECEIVED BY:  
 Umatilla County Surveyor  
 Date: 6-10  
 Rec'd By: KK  
 No. 10-95-C

REGISTERED  
 PROFESSIONAL  
 LAND SURVEYOR

*Stephen K. Haddock*

OREGON  
 JULY 9, 2001  
 STEPHEN K. HADDOCK  
 56295LS

RENEWAL DATE 6-30-11