

OREGON CORNER RESTORATION FORM

Section 23 Township 1N Range 32E
County Umatilla Date: June 29, 2009

Corner Designation: 1N32R17

Corner common to sections 22, 23, 26, and 27,
T1N, R32E, W.M., Umatilla County, Oregon.


Previous Renewals / Surveys, etc.

Corner originally set by Daniel Chaplin under contract No. 107 dated September 21, 1864. His record reads: Set post for corner to secs. 22, 23, 26, and 27 in mound of earth with charred stake, pits as per instructions. In survey 02-161-B I set a 1"x24" iron rebar with a 2" aluminum cap stamped as shown below.

- Condition Report Only
- Not found
- Remonumented
- Unrecorded
- Surveyed in
- Referenced out

Monument and Accessories found: (condition and source)
I found my monument from 02-161-B in good condition.

DIAGRAM

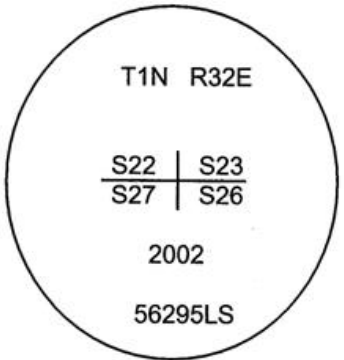

SKETCH

MONUMENT (S) AND ACCESSORIES SET (Procedures and Description)
None. This certificate is being recorded to report the state plane coordinates shown below.

For references:

The monument was tied using a Trimble R7/R8 RTK GPS system.

Location and comments
NAD 83/1991 State Plane Coordinate
Oregon North Zone
N = 689,137.28 ift
e = 8,640,939.15 ift

Compass Declination

Surveyors Seal

RECEIVED BY:
Umatilla County Surveyor
Date: 6-10
Rec'd By: KK
No. 10-93-6

Firm / Agency
Witness Tree Surveying
Address
P.O. Box G
Pilot Rock, Or. 97868
Party Chief
Stephen K, Haddock

REGISTERED
PROFESSIONAL
LAND SURVEYOR

Stephen K. Haddock

OREGON
JULY 9, 2001
STEPHEN K. HADDOCK
56295LS

RENEWAL DATE 6-30-11