

**OREGON CORNER RESTORATION FORM**

Section 24 Township 1N Range 32E  
 County Umatilla Date: July 13, 2009

Corner Designation: 1N32R23  
 Quarter corner common to sections 24 and 25,  
 T1N, R32E, W.M., Umatilla County, Oregon.



Condition Report Only  
 Not found  
 Remonumented  
 Unrecorded  
 Surveyed in  
 Referenced out

Previous Renewals / Surveys, etc.

Corner originally set by Daniel Chaplin under contract No. 107 dated September 21, 1864.  
 His record reads: Set post for 1/4 sec. cor. in mound of earth with charred stake, pits &c as per instructions. Zenas F. Moody under contract No. 164 dated October 4, 1871, stated: Set post.  
 Currin and Noland under special contract dated May 4, 1887, stated: Set stone 8 x 12 x 14 ins.

Monument and Accessories found: ( condition and source )

None. The point falls in a plow berm which has fence wire at least 2 feet in the ground.

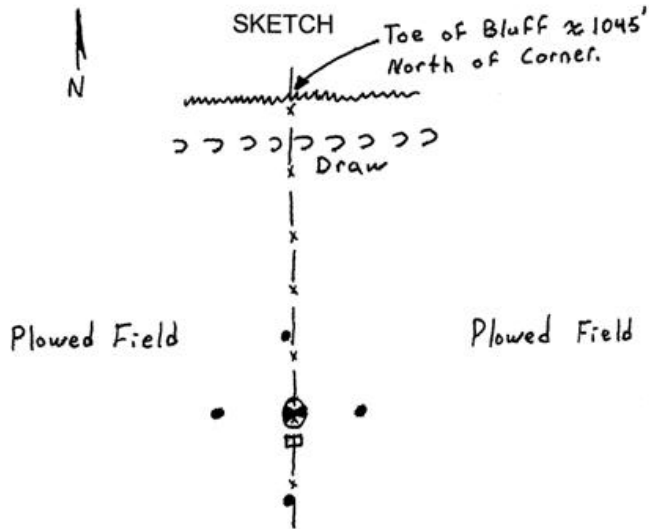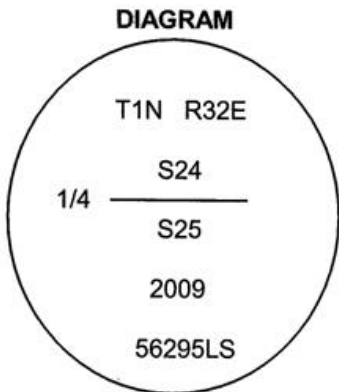

**MONUMENT (S) AND ACCESSORIES SET (Procedures and Description)**

At the intersection of the east - west section line and the north - south fence I set a 1 1/2" x 30" galvanized iron pipe with a 2 1/2" brass cap stamped as shown in the diagram above. The cap is 24" below the surface of the berm and the owner is reportedly going to remove the fence materials and level the berm.

For references, I set four 5/8" by 24" iron rebars with 1 1/4" orange plastic caps stamped WTS and 56295LS as described below:

- an iron rebar bears N02°33'59"W, 32.58 feet, 2 feet below the surface of the berm;
- an iron rebar bears N85°58'52"E, 30.64 feet, 2 feet below the surface of the field;
- an iron rebar bears S02°02'26"W, 36.90 feet, 2 feet below the surface of the berm;
- an iron rebar bears S86°38'30"W, 32.29 feet, 2 feet below the surface of the field;

The monument was set and references tied using a Trimble R7/R8 RTK GPS system.

Location and comments  
 NAD 83/1991 State Plane Coordinate  
 Oregon North Zone  
 N = 689,258.29 ift  
 E = 8,648,854.05 ift

Compass Declination  
 Firm / Agency  
 Witness Tree Surveying  
 Address  
 P.O. Box G  
 Pilot Rock, Or. 97868  
 Party Chief  
 Stephen K, Haddock

Surveyors Seal

RECEIVED BY:  
 Umatilla County Surveyor  
 Date: 6-10  
 Rec'd By: KK  
 No. 10-93-C

REGISTERED  
 PROFESSIONAL  
 LAND SURVEYOR

*Stephen K. Haddock*

OREGON  
 JULY 9, 2001  
 STEPHEN K. HADDOCK  
 56295LS

RENEWAL DATE 6-30-11