

OREGON CORNER RESTORATION FORM

Section 28 Township 1N Range 32E
 County Umatilla Date: September 14, 2009

Corner Designation: 1N32V13


Corner common to sections 27, 28, 33, and 34,
 T1N, R32E, W.M., Umatilla County, Oregon.

Previous Renewals / Surveys, etc.


Corner was originally set by Daniel Chaplin under contract No. 107 dated September 21, 1864. His record reads: Set post for corner to secs. 33, 34, 27 and 28 in mound of earth with charred stake, pits &c as per instructions.

Condition Report Only
 Not found
 Remonumented
 Unrecorded
 Surveyed in
 Referenced out

Monument and Accessories found: (condition and source)
 None. The point falls in a plowed field.

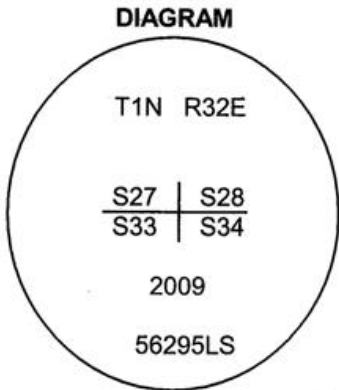

- ⊙ = Brass Cap
- = Rebar Reference
- = Steel Guard Post

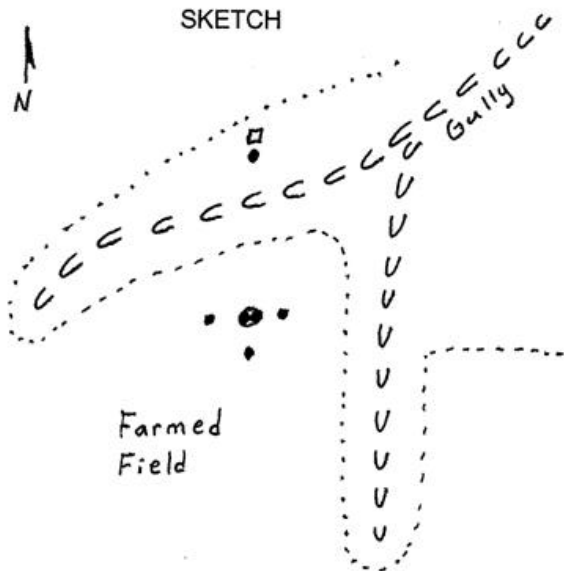

MONUMENT (S) AND ACCESSORIES SET (Procedures and Description)

At the proportionate point I set a 1 1/2" x 30" galvanized iron pipe with a 2 1/2" brass cap stamped as shown in the diagram above. The cap is 24" below the surface.

For references, I set four, 5/8" by 24" iron rebars with 1 1/4" orange plastic caps stamped WTS and 56295LS as described below:

- an iron rebar bears N01°31'23"W, 467.03 feet on a scab hillside;
- an iron rebar bears S74°44'47"E, 35.72 feet, 2 feet below the surface of the field;
- an iron rebar bears S01°41'03"E, 42.26 feet, 2 feet below the surface of the field;
- an iron rebar bears S70°00'33"W, 36.30 feet, 2 feet below the surface of the field;

The monument was set and references tied using a Trimble R7/R8 RTK GPS system.

Location and comments
 NAD 83/1991 State Plane Coordinate
 Oregon North Zone
 N = 683,782.92 ft
 E = 8,635,791.33 ft

Compass Declination

Surveyors Seal

RECEIVED BY:
Umatilla County Surveyor
 Date: 6-10
 Rec'd By: KK
 No. 10-93-C

Firm / Agency
 Witness Tree Surveying
 Address
 P.O. Box G
 Pilot Rock, Or. 97868
 Party Chief
 Stephen K, Haddock

REGISTERED
 PROFESSIONAL
 LAND SURVEYOR

Stephen K. Haddock

OREGON
 JULY 9, 2001
 STEPHEN K. HADDOCK
 56295LS

RENEWAL DATE 6-30-11