

OREGON CORNER RESTORATION FORM

Section 25 Township 1N Range 32E
 County Umatilla Date: June 29, 2009

Corner Designation: 1N32V23

Condition Report Only
 Not found
 Remonumented
 Unrecorded
 Surveyed in
 Referenced out


Quarter corner common to sections 25 and 36,
 T1N, R32E, W.M., Umatilla County, Oregon.

Previous Renewals / Surveys, etc.

Corner originally set by Daniel Chaplin under contract No. 107 dated September 21, 1864. His record reads: Set stone, 18 x 10 x 10, for 1/4 sec. cor. Zenas F. Moody under contract No. 164 dated October 4, 1871, states: Set post. Currin and Noland under special contract dated May 4, 1887, state: Set basalt stone 18 x 10 x 8. David Krumbein, in survey 04-182-B states: Found fence line west, east, and south. Set brass cap.

Monument and Accessories found: (condition and source)

I found the brass cap by Krumbein at the fence corner as indicated. The cap was not marked and none of the reported reference monuments had been set.

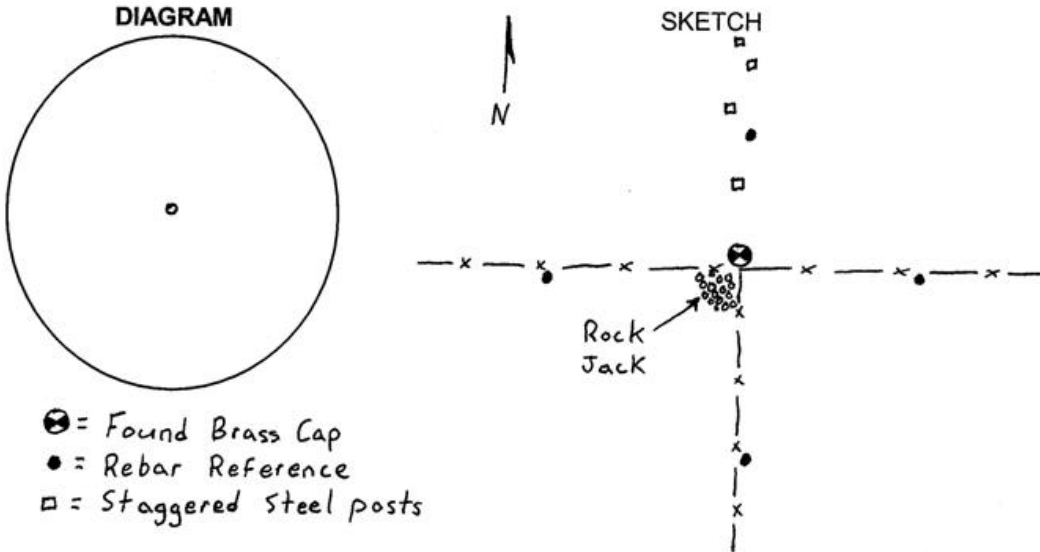

MONUMENT (S) AND ACCESSORIES SET (Procedures and Description)
 I held the brass cap by Krumbein and did not stamp the cap.

For references, I set four 5/8" by 24" iron rebars with 1 1/4" orange plastic caps stamped WTS and 56295LS as described below:
 an iron rebar bears N00°21'45"E, 98.94 feet;
 an iron rebar bears S88°20'38"E, 56.96 feet under the existing fence;
 an iron rebar bears S00°48'39"W, 87.77 feet under the existing fence;
 an iron rebar bears N89°11'25"W, 54.95 feet under the existing fence;

The monument and references were tied using a Trimble R7/R8 RTK GPS system.

Location and comments
 NAD 83/1991 State Plane Coordinate
 Oregon North Zone
 N = 684,043.49 ift
 E = 8,648,968.77 ift

Compass Declination
 Firm / Agency
 Witness Tree Surveying
 Address
 P.O. Box G
 Pilot Rock, Or. 97868
 Party Chief
 Stephen K, Haddock

Surveyors Seal

REGISTERED
 PROFESSIONAL
 LAND SURVEYOR

Stephen K. Haddock

OREGON
 JULY 8, 2001
 STEPHEN K. HADDOCK
 56295LS

RENEWAL DATE 6-30-11

RECEIVED BY:
 Umatilla County Surveyor
 Date: 6-10
 Rec'd By: KK
 No. 10-23-C