

OREGON CORNER RESTORATION FORM

Section 33 Township 1N Range 32E
County Umatilla Date: July 28, 2009


Corner Designation: 1N32Z13 Condition Report Only
Not found
Remonumented
Unrecorded
Surveyed in
Referenced out

South section corner to Sections 33 and 34 T1N, R32E
W.M., Umatilla County.

Previous Renewals / Surveys, etc.
Corner originally set by David P. Thompson under contract No. 79, dated July 26, 1858. His record reads: Set post for corner to secs. 33 and 34 in mound of earth with charred stake, pits, & trench. Aubrey Perry, in the Record of Private Surveys, Book 2, Page 299 says: moved Kimbrell's rock, 6x6x14, 15lks north and reset at this point. David L. Haddock in survey 97-14--C says: set a 1.25" x 30" galvanized iron pipe with a 2.25" brass cap on top of the stone.

Monument and Accessories found: (condition and source)
I found the brass cap as described by Haddock in good condition.

DIAGRAM

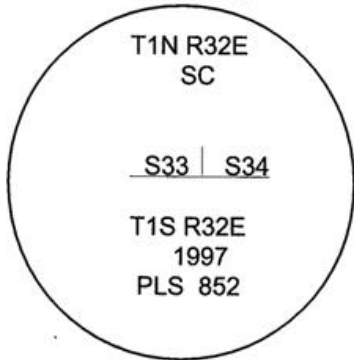

SKETCH

MONUMENT (S) AND ACCESSORIES SET (Procedures and Description)
None.

This monument was tied to report the Oregon State Plane, NAD 83/1991 coordinates only.

Measurements were made with a Trimble R7/R8 RTK GPS system.

Location and comments
NAD 83/1991 State Plane Coordinate
Oregon North Zone
N = 678,492.41 ift
E = 8,635,888.53 ift

Compass Declination

Surveyors Seal

REGISTERED
PROFESSIONAL
LAND SURVEYOR

Stephen K. Haddock

OREGON
JULY 9, 2001
STEPHEN K. HADDOCK
56295LS

RENEWAL DATE 6-30-11

RECEIVED BY:
Umatilla County Surveyor
Date: 6-10
Rec'd By: KK
No. 10-93-C

Firm / Agency
Witness Tree Surveying
Address
P.O. Box G
Pilot Rock, OR 97868
Party Chief
Stephen K, Haddock