

CERTIFIED RECORD OF LAND CORNER MONUMENTATION


South quarter corner to Section 31, T1N, R32E, W M.

Index: 1N 32 Z-3

History of original corner establishment:
Corner originally set by Thompson in contract 79 dated 1858. His record reads: 40.00 Set post for 1/4 sec. corner and build a mound of earth as per instructions.

An error was discovered in the chaining of the baseline. Thompson in contract 106, in 1864, reset this corner. His record reads: 40.00 Set stone 15x8x8 ins., for 1/4 sec. corner.

DIAGRAM

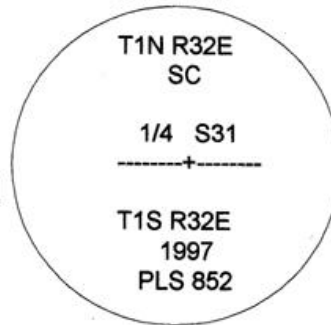

Evidence Found: None

Description of monument and accessories I established to perpetuate the location of this corner:

At the proportionate point between the corner of T1N, R31E and 32E, and the found stone, set by survey recorded in Record of Private Surveys, book 2, page 299, for corner to Sections 32 and 33, T1N, R32E.

I set a 1.25" x 12" galvanized iron pipe with 2.25" brass cap stamped as shown in the diagram and 20" below the surface of the ground in a wheat field about 450' west of the draw bottom. The monument was cemented in a hole chiseled into rock.

I set four 5/8" by 24" rebars with 1.25" red plastic caps stamped ORLS 852 and WALS 13922 as described below:

- a rebar bears N83°19'28"E, 481.56 feet at the foot of a wood fence post;
- a rebar bears S73°31'14"E, 488.61 feet on top of a small rock bluff;
- a rebar bears S61°02'55"E, 479.66 feet at the foot of a steel fence post;
- a rebar bears S40°19'04"E, 465.07 feet at the foot of a steel fence post;

The bearings are true.

This work was done June 17, 1997, and witnessed by Stephen K. Haddock.

Office of _____, I hereby certify that the within instrument was filed
 State of _____ County of Umatilla
 in this office for record on the _____ day of _ by _____
 _____ (COUNTY OFFICIAL) _____ (DEPUTY)

REGISTERED PROFESSIONAL LAND SURVEYOR

David L. Haddock

OREGON JULY 18, 1908 DAVID L. HADDOCK 852

RECEIVED BY
 Umatilla County Surveyor
 Date 7-97
 Rec'd By SK
 No. 97-140-C