


CERTIFIED RECORD OF LAND CORNER MONUMENTATION

Corner to Section 36, T1N, R32E, and Section 31,
T1N, R33E, W M.

Index: 1N 32 Z-25

DIAGRAM

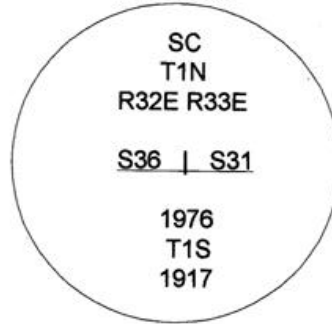

History of original corner establishment:

Corner originally set by Thompson in contract 79 dated 1858. His record reads: Set a post for corner to Township 1 North of Ranges 32 and 33 East and build mound as per instructions.

In 1887, under special instructions, Currin found and remonumented this corner by setting a basalt stone, 16x14x10 ins., 11 ins. in the ground marked SC with 6 notches on N, E and W edges and raised a mound of stone, pits and raised a mound of stone.

In 1917, Wilkes under contract #29 set an iron post, 3 ft. long, 2 ins. diam., 24 ins. in the ground, for standard cor. of Tps. 1 N., Rs. 32 and 33 E., with brass cap with original markings.

In 1976, Scherler, Group #921, restamped the cap (see diagram).

Evidence Found: Found the standard GLO brass capped monuments as described by Scherler. The monument was under a rock jack in an east - west fence line.

Description of monument and accessories I established to perpetuate the original location of this corner:

I set four 5/8" by 24" rebars with 1.25" red plastic caps stamped ORLS 852 and WAL5 13922 as described below:

- a rebar bears S89°39'W, 102.10' under the east - west fence;
- a rebar bears S89°19'W, 40.13' under the east - west fence;
- a rebar bears S89°42'E, 49.18' under the east - west fence;
- a rebar bears S89°51'E, 99.11' under the east - west fence.

The bearings are true.

This work was done June 10, 1997, and witnessed by Stephen K. Haddock.

Office of _____ County of Umatilla
 State of _____, I hereby certify that the within instrument was filed
 in this office for record on the _____ day of _____, 19____.
 _____ by _____
 (COUNTY OFFICIAL) (DEPUTY)



David L. Haddock



RECEIVED BY

Umatilla County Surveyor

Date 7-97

Rec'd By SK

No. 97-140-C