


OREGON CORNER RESTORATION FORM

Section 4 Township 1N Range 34E

County Umatilla Date 9/21/87

Corner Designation

S.E. 1/16

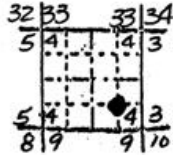

- Condition Report Only
- Not Found
- Renewed
- Unrecorded
- Surveyed In
- Referenced Out

Previous Renewals/Surveys, etc.

Gov't. Indian Allotment survey, 1919.


Monument(s) & Accessories Found: (Condition and Source)

Found brass cap on 2" iron pipe.  
No BT's found.

Monument Detail



Sketch

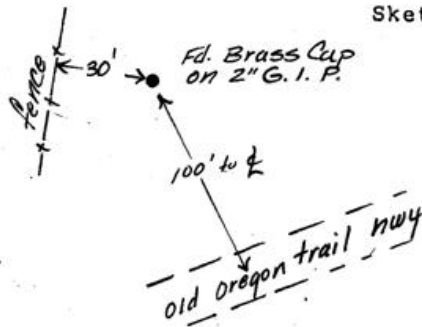

Monument Set (Procedures and Description)

New Accessories

Location & Comments

Blue Mountain Forest  
Wayside boundary  
survey, SE 1/4 Sec. 4  
and S 1/2 Sec. 3.

Compass Declination 20°

Firm/Agency Oregon State  
Parks & Recreation Div.

Address 525 Trade Street SE  
Salem OR 97310

Party Chief R. Hemmer

Notes R. Hemmer

Witness R. Hill, H. Hanson

Seal

REGISTERED  
PROFESSIONAL  
LAND SURVEYOR

*John E. Hollingsworth*

OREGON  
JULY 9, 1958  
JOHN E. HOLLINGSWORTH  
691

RECEIVED BY

Umatilla County Surveyor

Date 2-88

Rec'd By JA

No. 88-10-B