

5-13


OREGON CORNER RESTORATION FORM

Section 3 Township 1N Range 34E

County Umatilla Date 9/21/87

Corner Designation

S. 1/16 Corner
between 4 & 3

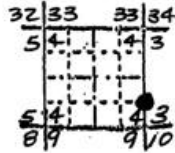

- Condition Report Only
- Not Found
- Renewed
- Unrecorded
- Surveyed In
- Referenced Out

Previous Renewals/Surveys, etc.

Gov't. Indian Allotment survey, 1919.


Monument(s) & Accessories Found: (Condition and Source)

Found brass cap on a 2" iron pipe.
No BT's found.

Monument Detail



Sketch

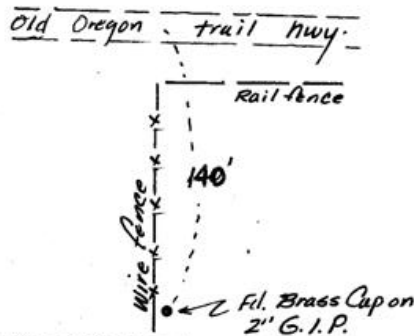

Monument Set (Procedures and Description)

New Accessories

Location & Comments

Blue Mountain Forest
Wayside boundary
survey SE 1/4 Sec. 4,
and S 1/2 Sec. 3.

RECEIVED BY

Umatilla County Surveyor
Date 2-88
Rec'd By RA
No. 88-10-B

Compass Declination 20°
Firm/Agency Oregon State
Parks & Recreation Div.
Address 525 Trade Street SE
Salem OR 97310
Party Chief R. Hemmer
Notes R. Hemmer
Witness R. Hill, H. Hanson

Seal

