

CERTIFIED RECORD OF LAND CORNER MONUMENTATION

HISTORY OF ORIGINAL CORNER ESTABLISHED:

Corner monumented by James Currin and James NoLand under special GIO contract dated May 4, 1887. Surveyor General field notes state:

Set basalt stone 18x9x9 in, 14 ins. in the ground marked 3 notches on S and 2 notches on E. edges for cor to secs 14, 15, 22 and 23. Raised mound of stone over it.

T 1 N R 34 E N-17

	S	
	15	

DESCRIPTION OF CORNER EVIDENCE FOUND:

Found a prominent collar of stone, 3 ft. diameter. By survey, I find this collar of stone to be harmonious in bearing and distance to nearest adjacent corners and accept this as the remains of the original stone mound.

SEE SURVEY FOR CTUIR DATED MAY 2019

DESCRIPTION OF MONUMENT AND ACCESSORIES I ESTABLISHED TO PERPETUATE THE

ORIGINAL LOCATION OF THIS CORNER:


At center of the collar of stone, I set a 2 ½" x 30" aluminum pipe, with 3" aluminum cap, marked a shown below, 10" in the ground, in a collar of stone 3 ft. diam., from which:

NEW BEARING OBJECTS:


- A rock outcrop bears North 68°43' East, a distance of 117.54 feet, marked "X BO".
- A 5/8" x 15" iron pin bears South 60°35' East, a distance of 24.85 feet, marked SE RP.
- A 5/8" x 15" iron pin bears South 54°34' West, a distance of 22.06 feet, marked SW RP.
- A 5/8" x 15" iron pin bears North 39°47' West, a distance of 44.57 feet, marked NW RP.

Fence falls South approx. 12 feet.

I hereby certify that the corner was monumented on May 7, 2019.

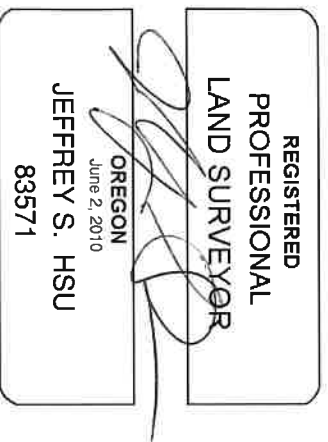

Renewal Date: June 30, 2019

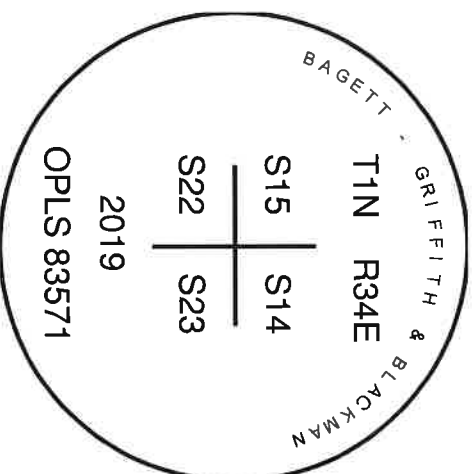

I use a Leica RTK GPS in the establishment of the accessories. Basis of bearing is as per Survey for CTUIR dated May 2019. Bearings and distances are the center of the aluminum cap and the center of the chiseled 'X'.