


CERTIFIED RECORD OF LAND CORNER MONUMENTATION

HISTORY OF ORIGINAL CORNER ESTABLISHED:

The Original Redfield Field Notes of the Umatilla Indian Reservation dated 1917-1919, Book #1, Umatilla County Surveyor Records shows that in 1919, Redfield, as part of the allotments and patents of the Umatilla Indian Reservation, set a monument.

T 1 N R 35 E B-20

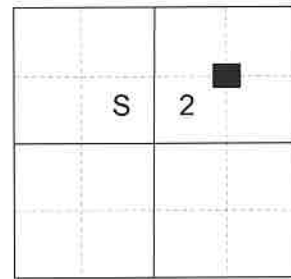

DESCRIPTION OF CORNER EVIDENCE FOUND:

Found a 2 1/2" galvanized iron pipe with with 2 1/2" brass cap, 24" above ground and in a 3' diam. collar of stone.

DESCRIPTION OF MONUMENT AND ACCESSORIES I ESTABLISHED TO PERPETUATE THE ORIGINAL LOCATION OF THIS CORNER:

At the base of the iron pipe I rebuild the 3' diam. mound of stone, from which:

NEW BEARING OBJECTS:

A 4' x 4' stone face bears South 52° East, a dist. of 7.30 feet, marked X BO


A 2' x 2' stone face in 60' long rock bluff bears South 62° West, a dist. of 3.15 feet, marked X BO

I hereby certify that the corner was perpetuated
August 28, 2025

Witness: Kyle Tucker



Renewal Date: June 30, 2027

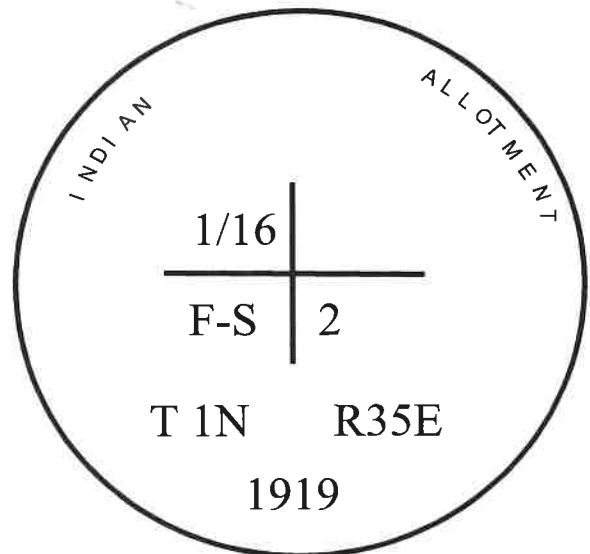

I use a tape and compass in the establishment of the new bearing objects. Bearings and distances are measured from the center of the brass cap to the center of the chiseled X's