


CERTIFIED RECORD OF LAND CORNER MONUMENTATION

HISTORY OF ORIGINAL CORNER ESTABLISHED:

The Original Redfield Field Notes of the Umatilla Indian Reservation dated 1917-1919, Book #1, Umatilla County Surveyor Records shows that in 1919, Redfield, as part of the allotments and patents of the Umatilla Indian Reservation, set a monument.

T 1 N R 35 E C-20

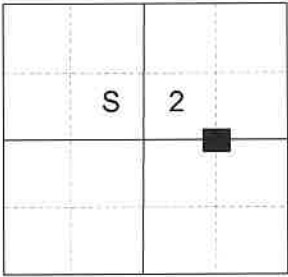

DESCRIPTION OF CORNER EVIDENCE FOUND:

None found. A large overturned root wad occupies the monument position.

DESCRIPTION OF MONUMENT AND ACCESSORIES I ESTABLISHED TO MONUMENT THE ORIGINAL LOCATION OF THIS CORNER:


At proportionate position, I set a 5/8" x 30" iron pin, 26" in the ground, with 2 1/2" aluminum cap marked as shown below, from which:

NEW BEARING OBJECTS:

- A 6" diam. Douglas Fir bears South 74° East, a dist. of 8.30 feet, marked CE 1/16 S2 BT.
- A 21" diam. Douglas Fir bears South 76° West, a dist. of 26.55 feet, marked CE 1/16 S2 BT.

I hereby certify that the corner was monumented September 9, 2025

Witness: Kyle Tucker

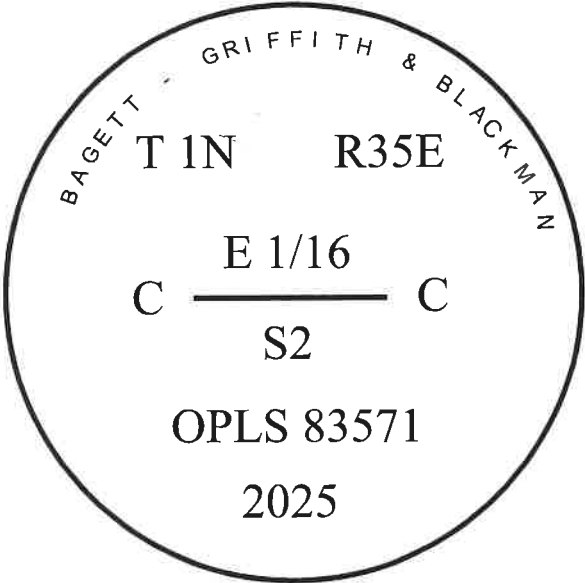

Renewal Date: June 30, 2027

I use a tape and compass in the establishment of the new bearing trees. Bearings are measured from the center of the aluminum cap to a brass washer marked "OPLS 83571" tacked to the BT blaze using 14° East for declination. Distances are measured from the center of the aluminum cap to a 60D spike in the center right base of the tree.