

CERTIFIED RECORD OF LAND CORNER MONUMENTATION

HISTORY OF ORIGINAL CORNER ESTABLISHED:


Corner was originally established under GLO Special Joint Contract, dated May 4th, 1887, executed by Currin and Noland. Surveyor General field notes state:

Set post 3 ft. long, 3 ins. square, 24 ins. in the ground for 1/4 S Cor. marked 1/4 S on N face, from which:

A Fir 4 ins. diam. bears N20°W 20 lks. dist. marked 1/4 S BT

A Spruce 8 ins. diam. bears S87°W 50 lks. dist. marked 1/4 S BT

T 1 N R 35 E E-19

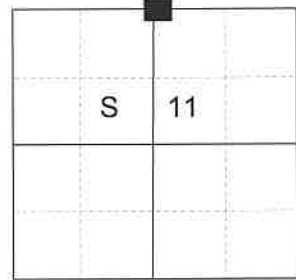

The Original Redfield Field Notes of the Umatilla Indian Reservation dated 1917-1919, Book #1, Umatilla County Surveyor Records shows that in 1919, Redfield, as part of the allotments and patents of the Umatilla Indian Reservation, set a monument.

DESCRIPTION OF CORNER EVIDENCE FOUND:

Found a 2 1/2" galvanized pipe with 2 1/2" brass cap marked as shown below, 6" above ground in 2' diam. mound of stone. No original bearing trees could be found.

DESCRIPTION OF MONUMENT AND ACCESSORIES I ESTABLISHED TO PERPETUATE THE ORIGINAL LOCATION OF THIS CORNER:

From the iron pipe monument:

NEW BEARING OBJECTS:

A 4" diam. White Fir bears North 47° East, a dist. of 21.70 feet, marked 1/4 S2 BT


A 19" diam. Douglas Fir bears South 41° East, a dist. of 41.75 feet, marked 1/4 S11 BT

A 6" diam. Douglas Fir bears South 83° West, a dist. of 50.05 feet, marked 1/4 S11 BT

A 23" diam. White Fir bears North 17° West, a dist. of 19.15 feet, marked X BO

I hereby certify that the corner was perpetuated September 8, 2025

Witness: Kyle Tucker

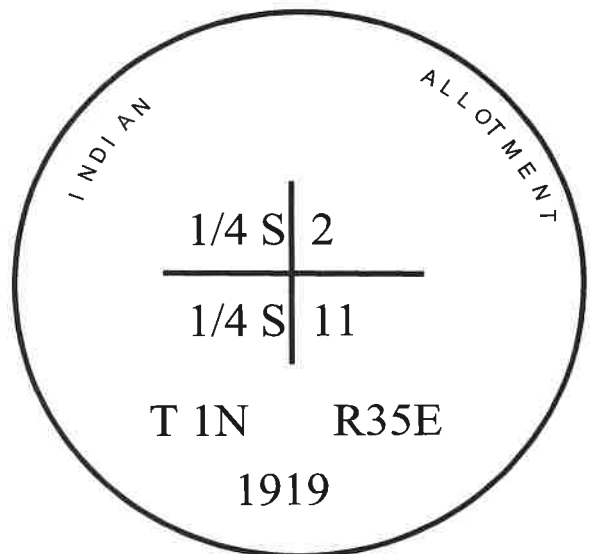

REGISTERED
PROFESSIONAL
LAND SURVEYOR

OREGON
June 2, 2010

JEFFREY S. HSU
83571

Renewal Date: June 30, 2027

I use a tape and compass in the establishment of the new bearing trees. Bearings are measured from the center of the aluminum cap to a brass washer marked "OPLS 83571" tacked to the BT blaze using 14° East for declination. Distances are measured to from the center of the aluminum cap to a 60D spike in the center right base of the tree.

E-19

25-087-6