
## CERTIFIED RECORD OF LAND CORNER MONUMENTATION

## HISTORY OF ORIGINAL CORNER ESTABLISHED:

The Original Redfield Field Notes of the Umatilla Indian Reservation dated 1917-1919, Book #1, Umatilla County Surveyor Records shows that in 1919, Redfield, as part of the allotments and patents of the Umatilla Indian Reservation, set a monument.

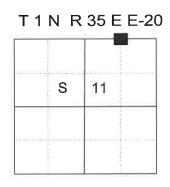

#### DESCRIPTION OF CORNER EVIDENCE FOUND:

Found a 2 1/2" galvanized iron pipe with with 2 1/2" brass cap, 30" above ground and leaning downhill in 3' diam. x 12" tall mound of stone.

# DESCRIPTION OF MONUMENT AND ACCESSORIES I ESTABLISHED TO PERPETUATE THE ORIGINAL LOCATION OF THIS CORNER:

At the position of the base of the pipe, I reset it upright and rebuild the stone mound to a diam. of 5' and within 15" of the brass cap, from which:

## NEW BEARING OBJECTS:

A 10' tall x 60' long rock outcrop bears North 23°14' East, a dist. of 35.93 feet, marked X BO

A 10' tall x 60' long rock outcrop bears South 82°36' East, a dist. of 44.36 feet, marked X BO.


I hereby certify that the corner was perpetuated August 26, 2025

Witness: Kyle Tucker

REGISTERED
PROFESSIONAL
LAND SURVEYOR

OREGON
June 2, 2010
JEFFREY S. HSU
83571

Renewal Date: June 30, 2027

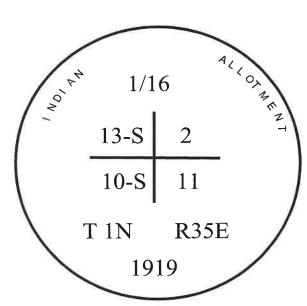

I use a Leica GS18 with RTK in the establishment of the new bearing objects. Basis of Bearing is as per map of survey filed concurrently. Bearings and distances are measured to the center of the chiseled  $X^{\prime}s$ .