


CERTIFIED RECORD OF LAND CORNER MONUMENTATION

HISTORY OF ORIGINAL CORNER ESTABLISHED:

The Original Redfield Field Notes of the Umatilla Indian Reservation dated 1917-1919, Book #1, Umatilla County Surveyor Records shows that in 1919, Redfield, as part of the allotments and patents of the Umatilla Indian Reservation, set a monument.

T 1 N R 35 E F-18

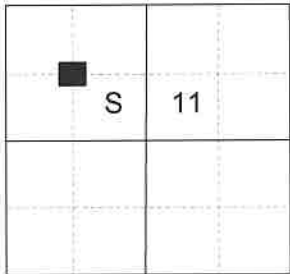

DESCRIPTION OF CORNER EVIDENCE FOUND:

Found a 2 1/2" galvanized iron pipe, 8" above ground, with 2 1/2" brass cap marked as shown below.

DESCRIPTION OF MONUMENT AND ACCESSORIES I ESTABLISHED TO MONUMENT THE ORIGINAL LOCATION OF THIS CORNER:

From the iron pipe monument:

NEW BEARING OBJECTS:

A 6" Douglas Fir bears North 80° East, a dist. of 35.15 feet, marked NW 1/16 S11 BT
A 3" Douglas Fir bears South 41° West, a dist. of 12.75 feet, bark scribed X BT


Set Steel fence post approx. 1 foot South

I hereby certify that the corner was monumented
September 10, 2025

Witness: Kyle Tucker



Renewal Date: June 30, 2027

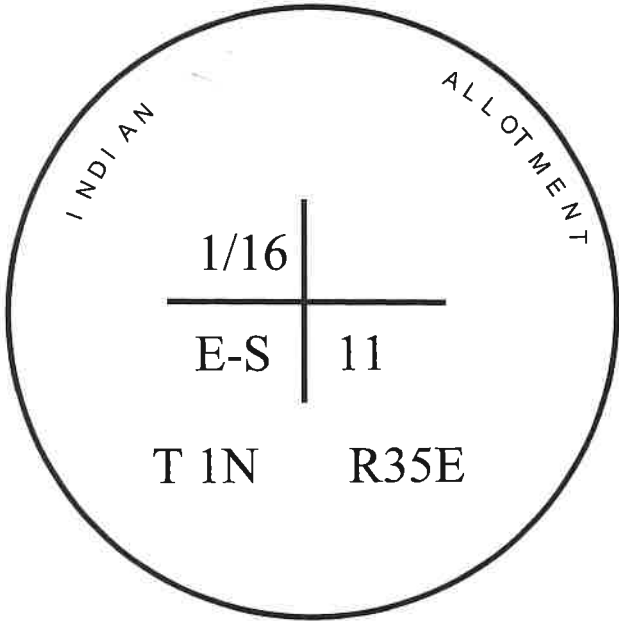

I use a tape and compass in the establishment of the new bearing trees. Bearings are measured from the center of the brass cap to a brass washer marked "OPLS 83571" tacked to the BT blaze using 14° East for declination. Distances are measured from the center of the brass cap to a 60D spike in the center right base of the trees.